VIRGIN ISLANDS DEPARTMENT OF EDUCATION

SCHEMATIC SITE PLANNING - TEMPORARY FACILITIES

AECOM

PRINCIPAL	MR. FRANCIOS
ENROLLMENT	.
SCHOOL OPENED	.
SITE VISIT DATE	FEB., 2015

ZONE AE
(EL 7)

NORTH

GREASE TRAP

MON GATE

SERVICE DOWN POLE UNDERGROUND TO TRANSFORMER

EXISTING UTILITY POLE

PROPOSED SERVICE FEED RUN UNDERGROUND TO SERVICE PANEL

PROPOSED PAD MOUNTED TRANSFORMER

EXISTING SEPTIC TANK (PENDING SURVEY VERIFICATION)

GATE

PIPE OUTLET

EXISTING GRAVITY SANITARY SEWER TO SEPTIC AND CITY MAIN CONNECTION (PER SCHOOL PERSONNEL; PENDING SURVEY VERIFICATION)

CONNECT TO EXISTING 2" WATERMAIN

EXISTING WATER METER AND 2" WATERMAIN

CONNECT TO EXISTING SANITARY SEWER CLEANOUT

EXISTING SANITARY LATERAL AND CLEANOUTS FOR THE EXISTING BUILDING RESTROOMS

PROPOSED WATERMAIN SERVICE TO BATHROOMS

PROPOSED SANITARY LATERAL FROM BATHROOMS TO EXISTING CLEANOUT

HILL STREET

PRINCE STREET

FRANK STREET

ROUTE 104

ROUTE 10

CMU RETAINING WALL

NOTE:

- NO ISSUES WITH DRAINAGE
- SEPTIC TANK IS PUMPED 3X A YEAR. IF SEPTIC TANK GETS FULL THEN THERE IS AN OVERFLOW LINE TO THE CITY SYSTEM.
- WATER IS CONNECTED TO GOV. SYSTEM, NO PROBLEMS WITH WATER PRESSURE.
- PARKING AREA SMALL, TEACHERS PARK ALONG STREET.
- BUSES DROP OFF KIDS, NO ISSUES W/ PICKUP BUT NO TURNAROUND FOR BUSES.
- FENCE IS OKAY.
- DEPARTMENT OF PARKS AND REC. OWNS THE FIELD. SCHOOL USES WALKWAY TO GET TO FIELD.

GRAPHIC LEGEND:

- CLASSROOMS (24' X 36')
- ADMINISTRATION (24' X 36') SPRUNG (SIZE VARIES)
- RESTROOMS (24' X 33')
- CLEARANCE
- EXISTING BUILDINGS
- SERVICE/STORAGE/KITCHEN
- LIBRARY

APPROVALS:

COMMISSIONER SHARON ANN MCCOLLUM, PHD

INSULAR SUPERINTENDENT DIONNE WELLS - HEDRINGTON
ST.THOMAS - ST.JOHN DISTRICT

LOCATION: **JULIUS E SPRAUVE ELEMENTARY SCHOOL** - ST. JOHN , USVI
24 CLASSROOMS (24' X 36') , 2 ADMINISTRATION (24' X 36'), 1 BATHROOM (24' X 33'), 2 SERVICE (24' X 36')
04 / 30 / 2018 REVISION 4

AECOM

SCALE: 1/128" = 1' - 0"

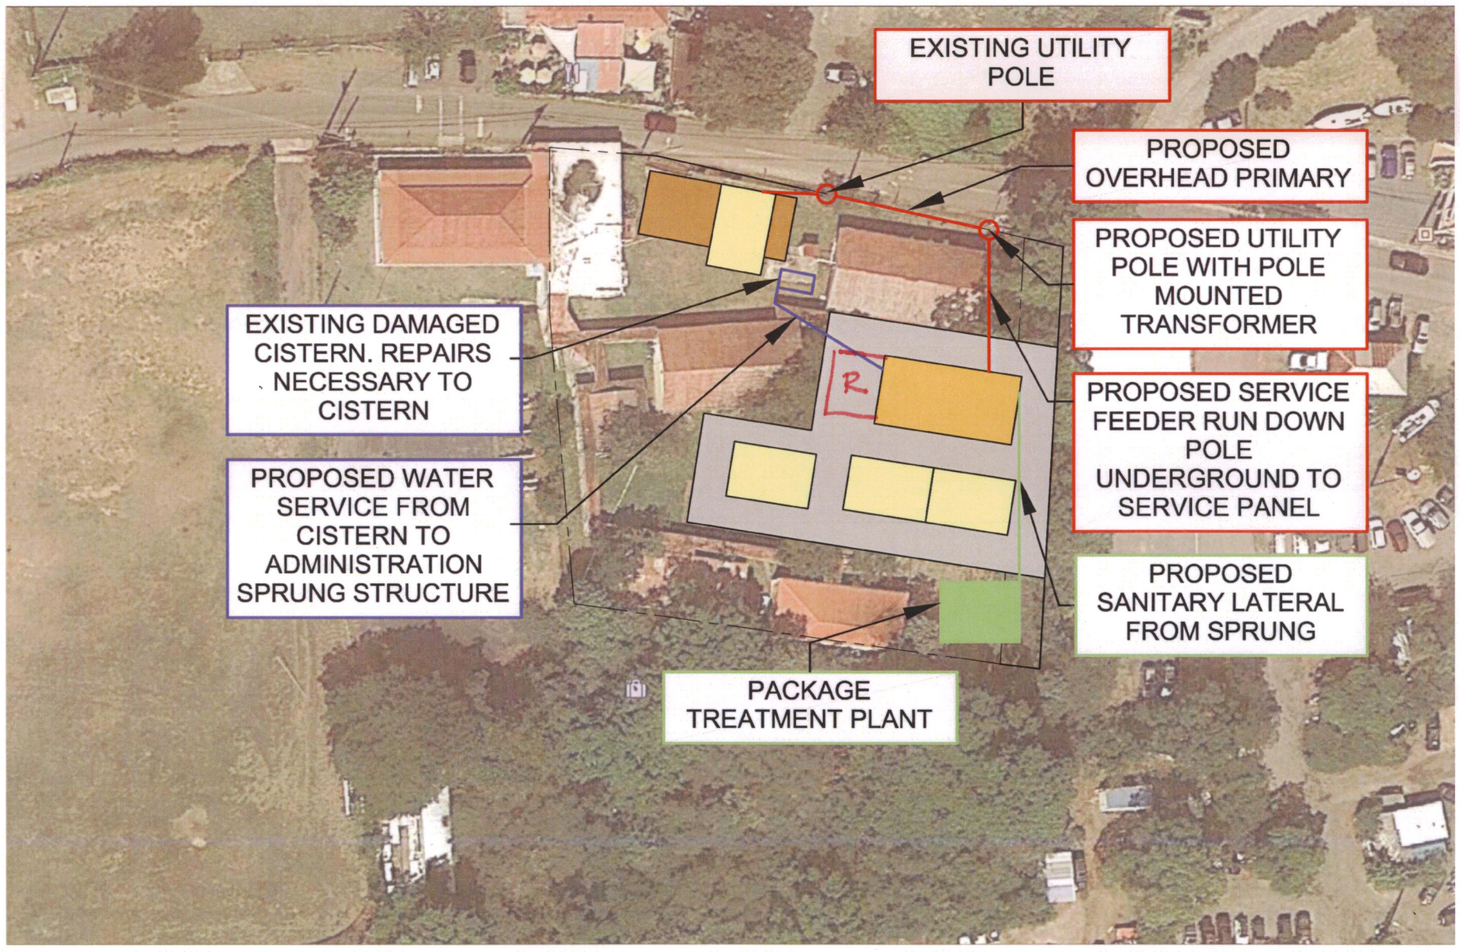

GRAPHIC LEGEND:

- CLASSROOMS (24' X 36')
- ADMINISTRATION (24' X 36') SPRUNG (SIZE VARIES)
- RESTROOMS (24' X 33')
- CLEARANCE
- EXISTING BUILDINGS
- SERVICE/STORAGE/KITCHEN
- LIBRARY

APPROVALS:

Sharon Ann McCollum

COMMISSIONER SHARON ANN MCCOLLUM, PHD

Dionne Wells Hedrington

INSULAR SUPERINTENDENT DIONNE WELLS - HEDRINGTON
ST.THOMAS - ST.JOHN DISTRICT

LOCATION: **GUY BENJAMIN ELEMENTARY SCHOOL** - ST. JOHN , USVI
4 CLASSROOMS (24' X 36') , 1 SPRUNG (30' X 60')
04 / 30 / 2018 REVISION 4

AECOM

SCALE: 1/64" = 1' - 0"

SCHOOL OPENED	2000
SITE VISIT DATE	FEB., 2015

ZONE X

NORTH

6 CLASSROOMS AND 1 RE-STROOM FOR ADDELITA CANCRYN JUNIOR HIGH SCHOOL AT LOCKHART

BRIDGE TO ADDALITA CANCRYN JUNIOR HIGH SCHOOL AT

PLENTY OF TREES NEED TO CUT. NEEDS REGULAR MAINTENANCE

NOTE:

- NO FLOODING, SOME LEAKS, POSSIBLY BY OLD CISTERNS
- SEWER IS CONNECTED TO GOV. SYSTEM FOR

APPROVALS:

COMMISSIONER SHARON ANN MCCOLLUM, PHD

INSULAR SUPERINTENDENT DIONNE WELLS - HEDRINGTON
ST.THOMAS - ST.JOHN DISTRICT

GRAPHIC LEGEND:

- CLASSROOMS (24' X 36')
- ADMINISTRATION (24' X 36') SPRUNG (SIZE VARIES)
- RESTROOMS (24' X 33')
- CLEARANCE
- EXISTING BUILDINGS
- SERVICE/STORAGE/CANOPY
- LIBRARY

A Admin
S Service
C classroom

LOCATION: **GLADYS A ABRAHAM ELEMENTARY SCHOOL AT LOCKHART - ADDELITA CANCRYN AT LOCKHART** - ST. THOMAS , USVI
18 CLASSROOMS (24' X 36') , 2 ADMINISTRATION (24' X 36'), 1 BATHROOM (24' X 33'), 1 SERVICE (24' X 36') 1 SPRUNG (60' X 90') - 6 CLASSROOMS (24' X 36')
05 / 01 / 2018 REVISION 5

AECOM

SCALE: 1/128" = 1' - 0"

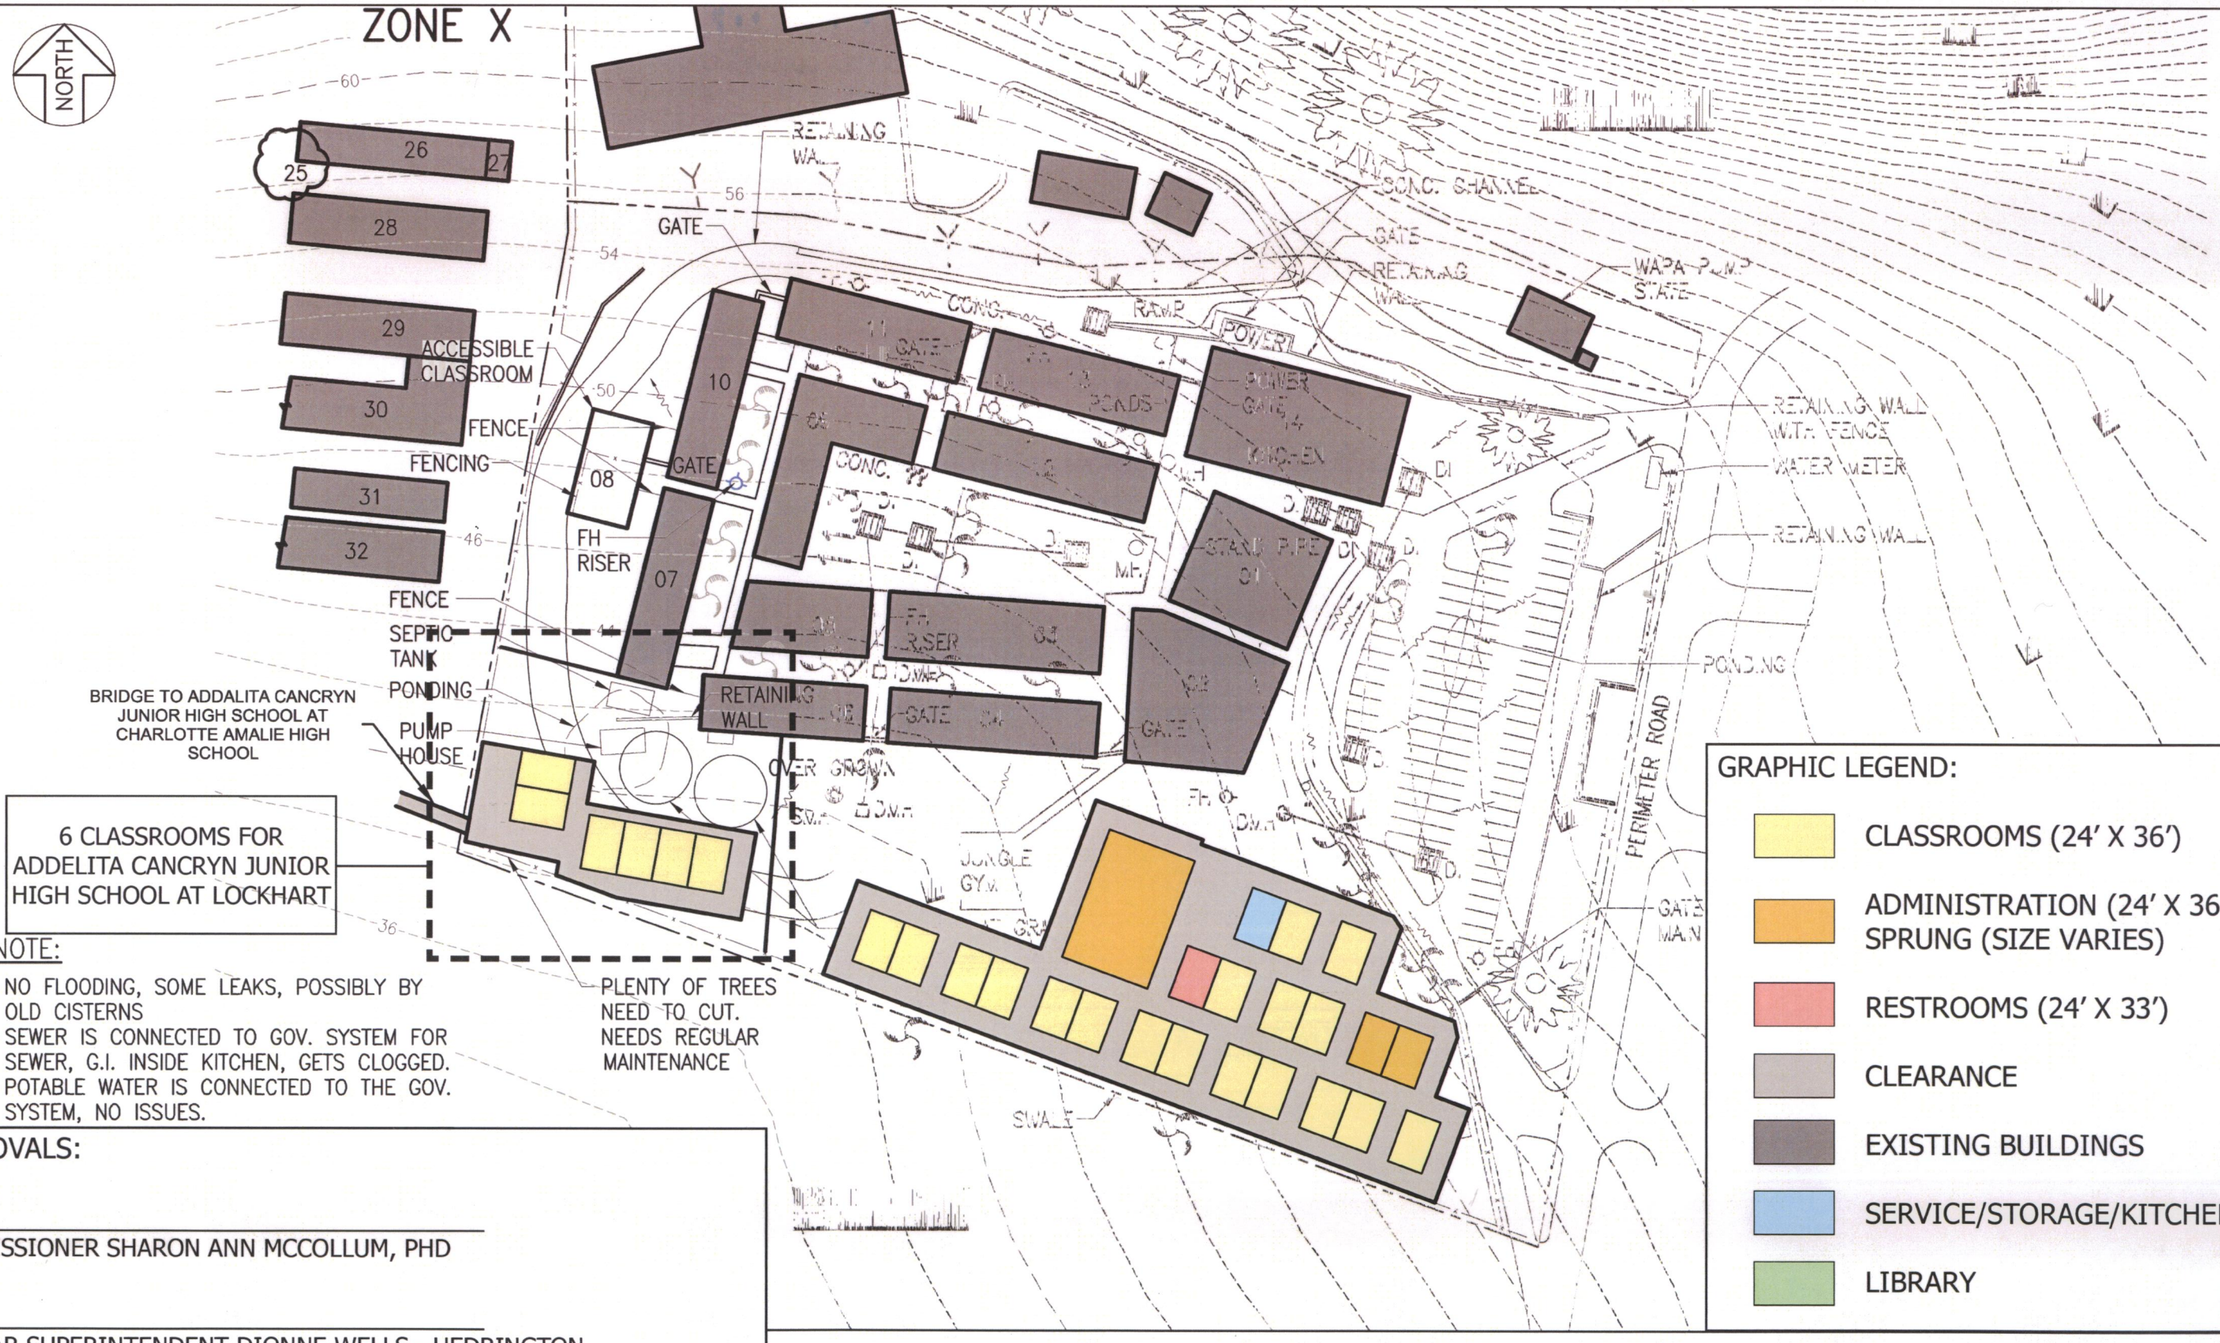

NOTE:

- NO FLOODING, SOME LEAKS, POSSIBLY BY OLD CISTERNS
- SEWER IS CONNECTED TO GOV. SYSTEM FOR SEWER, G.I. INSIDE KITCHEN, GETS CLOGGED.
- POTABLE WATER IS CONNECTED TO THE GOV. SYSTEM, NO ISSUES.

GRAPHIC LEGEND:

- CLASSROOMS (24' X 36')
- ADMINISTRATION (24' X 36') SPRUNG (SIZE VARIES)
- RESTROOMS (24' X 33')
- CLEARANCE
- EXISTING BUILDINGS
- SERVICE/STORAGE/KITCHEN
- LIBRARY

APPROVALS:

COMMISSIONER SHARON ANN MCCOLLUM, PHD

INSULAR SUPERINTENDENT DIONNE WELLS - HEDRINGTON
ST.THOMAS - ST.JOHN DISTRICT

LOCATION: **GLADYS A ABRAHAM ELEMENTARY SCHOOL AT LOCKHART - ADDELITA CANCRYN AT LOCKHART** - ST. THOMAS , USVI
18 CLASSROOMS (24' X 36') , 2 ADMINISTRATION (24' X 36'), 1 BATHROOM (24' X 33'), 1 SERVICE (24' X 36') 1 SPRUNG (60' X 90') - 6 CLASSROOMS (24' X 36')
04 / 30 / 2018 REVISION 4

AECOM

SCALE: 1/128" = 1' - 0"

PROPOSED SANITARY SEWER SERVICE, NEW MANHOLE AND CONNECTION TO EXISTING SYSTEM

ASSUMED LOCATION OF EXISTING SANITARY MAIN. EXACT LOCATION TO BE VERIFIED BY SURVEY

EXISTING WASTEWATER TREATMENT PLANT

WATER SERVICE PROVIDED BY CONNECTION TO EXISTING CISTERN. EXACT LOCATION TO BE VERIFIED BY SURVEY

ZONE X

PROPOSED FEEDER FROM SERVICE PANEL RUN UNDERGROUND TO OTHER BUILDINGS

RUN SERVICE FEEDER UNDERGROUND TO SERVICE PANEL

EXISTING UTILITY POLE

PROPOSED PAD MOUNTED TRANSFORMER

PROPOSED UTILITY POLE

PONDS

RETAINING WALL

FLOODS

RETAINING WALL

VAULTS

PLAYGROUND

- NO ISSUES W/ RAMPS OR S
- ONLY ONE AREA TO EVACUA

LEGEND:

FH: FIRE HYDRANT
DI: DRAIN INLET
SMH: SEWER MANHOLE
MH: MANHOLE
GT: GREASE TRAP

GRAPHIC LEGEND:

- CLASSROOMS (24' X 36')
- ADMINISTRATION (24' X 36') SPRUNG (SIZE VARIES)
- RESTROOMS (24' X 33')
- CLEARANCE
- EXISTING BUILDINGS
- SERVICE/STORAGE/KITCHEN
- LIBRARY

APPROVALS:

Sharon Ann McCollum

COMMISSIONER SHARON ANN MCCOLLUM, PHD

INSULAR SUPERINTENDENT DIONNE WELLS - HEDRINGTON
ST.THOMAS - ST.JOHN DISTRICT

LOCATION: **BENJAMIN OLIVER ELEMENTARY SCHOOL AT BOWSKY ELEMENTARY SCHOOL** - ST. THOMAS , USVI
12 CLASSROOMS (24' X 36') , 2 ADMINISTRATION (24' X 36'), ~~1 BATHROOM (24' X 33')~~.
04 / 30 / 2018 REVISION 4

AECOM

SCALE: 1/64" = 1' - 0"

SCHOOL OPENED	
SITE VISIT DATE	FEB., 2015

NORTH

NOTE:

- ASPHALT ROADWAYS IN POOR CONDITION
- B,C BACK OF BUILDINGS. SEEPS THROUGH BUILDING WALL
- BATHROOMS IN EVERY BUILDING
- GREASE INTERCEPTOR NEEDS TO GET PUMPED FROM TIME TO TIME
- WATER CONNECTED TO CITY SYSTEM
- ALSO CISTERN BELOW AUDITORIUM, USED FROM TIME TO TIME, BUT NOT NOW.
- POTABLE TESTED REGULARLY.
- WM AT FRONT OF SCHOOL.
- FH'S ON CAMPUS OPERATIONAL
- PARKING ADEQUATE FOR DAY TO DAY, OVERFLOWS DURING LARGE EVENTS. MOST KIDS WALK, 75% DROP OFF BY BUS OR DOLLAR SAFARI.
- PICK UP AND DROP OFF FLOWS OKAY
- NO ISSUES W/ RETAINING WALL.
- FENCE AROUND SCHOOL IS NOT COMPLETE, NEED TO FINISH.
- TRACK NEEDS TO BE RESURFACED.
- SOME CRACKING OF PAVEMENT.

LEGEND:

FH:	FIRE HYDRANT
DI:	DRAIN INLET
DMH:	DRAIN MANHOLE
SMH:	SEWER MANHOLE
T.D.:	TRENCH DRAIN

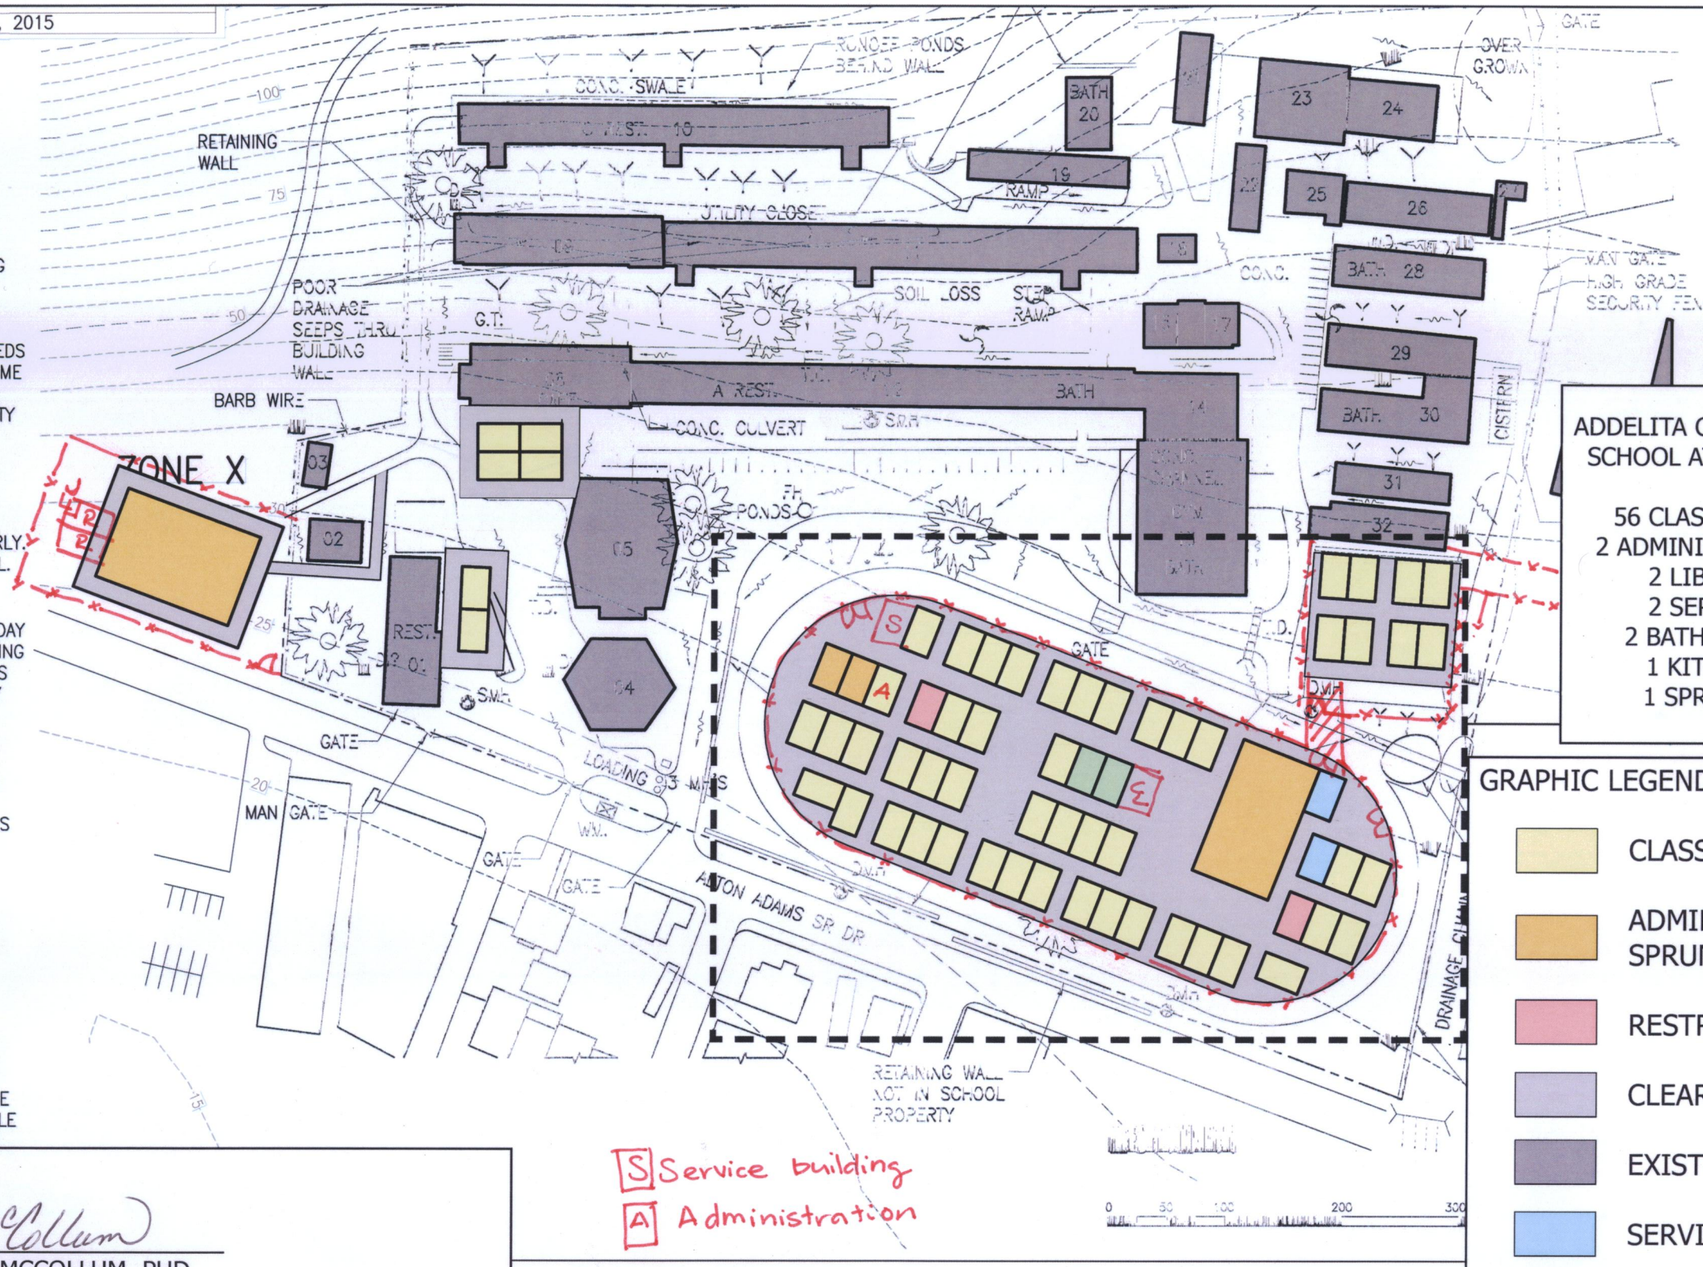

ADDELITA CANCRYN JUNIOR HIGH SCHOOL AT CHARLOTTE AMALIE

56 CLASSROOMS (24' X 36')
2 ADMINISTRATION (24' X 36')
2 LIBRARY (24' X 36')
2 SERVICE (24' X 36')
2 BATHROOMS (24' X 33')
1 KITCHEN (24' X 36')
1 SPRUNG (70' X 120')

GRAPHIC LEGEND:

- CLASSROOMS (24' X 36')
- ADMINISTRATION (24' X 36') SPRUNG (SIZE VARIES)
- RESTROOMS (24' X 33')
- CLEARANCE
- EXISTING BUILDINGS
- SERVICE/STORAGE/KITCHEN
- LIBRARY

APPROVALS:

Sharon Ann McCollum

COMMISSIONER SHARON ANN MCCOLLUM, PHD

INSULAR SUPERINTENDENT DIONNE WELLS - HEDRINGTON
ST.THOMAS - ST.JOHN DISTRICT

LOCATION: **CHARLOTTE AMALIE HIGH SCHOOL - ADDELITA CANCRYN AT CHARLOTTE AMALIE** - ST. THOMAS , USVI
6 CLASSROOMS (24' X 36') , 1 SPRUNG (80' X 120')
05 / 01 / 2018 REVISION 5

AECOM

SCALE: 1/128" = 1' - 0"

SCHOOL OPENED	
SITE VISIT DATE	FEB., 2015

NOTE:

- ASPHALT ROADWAYS IN POOR CONDITION
- B,C BACK OF BUILDINGS. SEEPS THROUGH BUILDING WALL
- BATHROOMS IN EVERY BUILDING
- GREASE INTERCEPTOR NEEDS TO GET PUMPED FROM TIME TO TIME
- WATER CONNECTED TO CITY SYSTEM
- ALSO CISTERN BELOW AUDITORIUM, USED FROM TIME TO TIME, BUT NOT NOW.
- POTABLE TESTED REGULARLY.
- WM AT FRONT OF SCHOOL.
- FH'S ON CAMPUS OPERATIONAL
- PARKING ADEQUATE FOR DAY TO DAY, OVERFLOWS DURING LARGE EVENTS. MOST KIDS WALK, 75% DROP OFF BY BUS OR DOLLAR SAFARI.
- PICK UP AND DROP OFF FLOWS OKAY
- NO ISSUES W/ RETAINING WALL.
- FENCE AROUND SCHOOL IS NOT COMPLETE, NEED TO FINISH.
- TRACK NEEDS TO BE RESURFACED.
- SOME CRACKING OF PAVEMENT.

LEGEND:

FH:	FIRE HYDRANT
DI:	DRAIN INLET
DMH:	DRAIN MANHOLE
SMH:	SEWER MANHOLE
T.D.:	TRENCH DRAIN

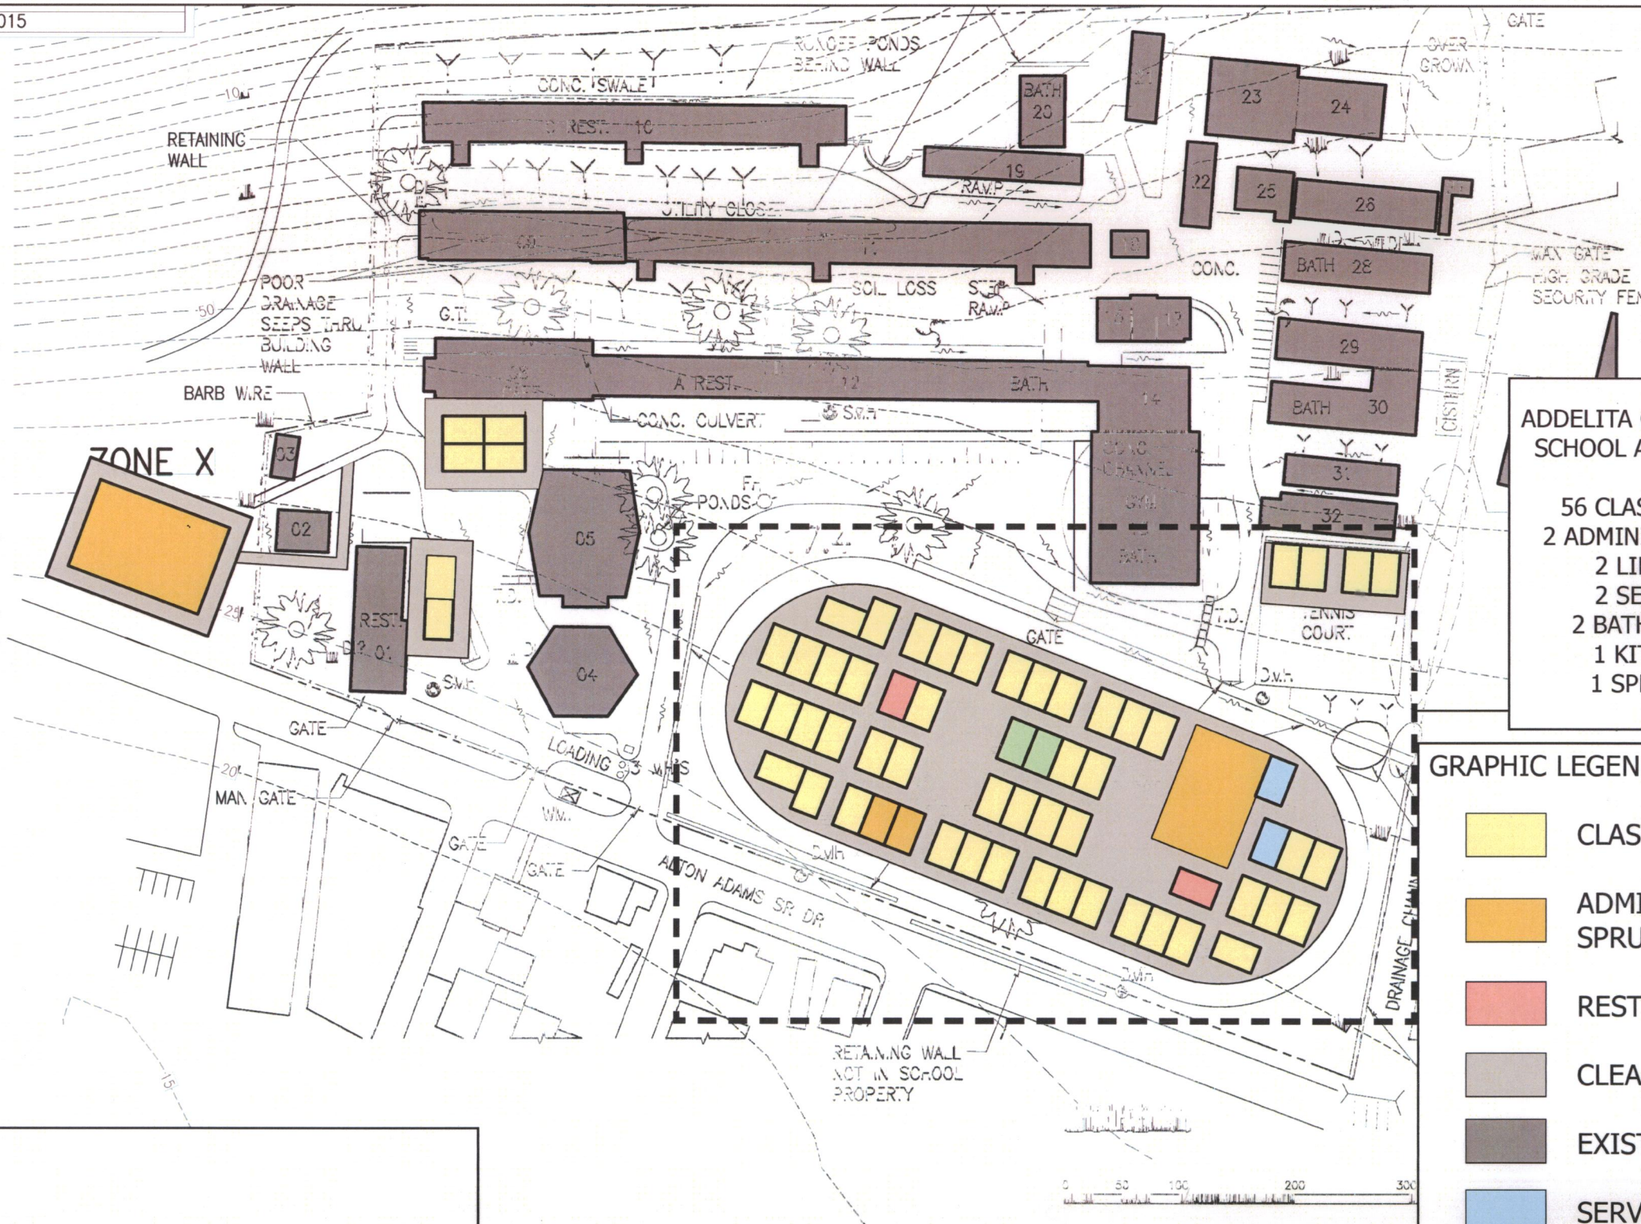

ADDELITA CANCRYN JUNIOR HIGH SCHOOL AT CHARLOTTE AMALIE

56 CLASSROOMS (24' X 36')
2 ADMINISTRATION (24' X 36')
2 LIBRARY (24' X 36')
2 SERVICE (24' X 36')
2 BATHROOMS (24' X 33')
1 KITCHEN (24' X 36')
1 SPRUNG (70' X 105')

GRAPHIC LEGEND:

- CLASSROOMS (24' X 36')
- ADMINISTRATION (24' X 36')
  SPRUNG (SIZE VARIES)
- RESTROOMS (24' X 33')
- CLEARANCE
- EXISTING BUILDINGS
- SERVICE/STORAGE/KITCHEN
- LIBRARY

APPROVALS:

_____

COMMISSIONER SHARON ANN MCCOLLUM, PHD

_____

INSULAR SUPERINTENDENT DIONNE WELLS - HEDRINGTON
ST.THOMAS - ST.JOHN DISTRICT

LOCATION: **CHARLOTTE AMALIE HIGH SCHOOL - ADDELITA CANCRYN AT CHARLOTTE AMALIE** - ST. THOMAS , USVI
6 CLASSROOMS (24' X 36') , 1 SPRUNG (80' X 120')
04 / 30 / 2018 REVISION 4

AECOM

SCALE: 1/128" = 1' - 0"

PRINCIPAL	MS. SALLY PETTY
ENROLLMENT	1000 STUDENTS
SCHOOL OPENED	
SITE VISIT DATE	FEB., 2015

NOTE:

- SEWER CONNECTED TO GOV. SYSTEM.
- NO ISSUES W/ G.T.
- WATER CONNECTED TO GOV. SYSTEM, PORTABLE WATER.
- FIRE HYDRANTS NOT ON CAMPUS.
- ENOUGH PARKING FOR TEACHERS, STAFF, VISITORS.
- PAVEMENT POOR CONDITION, A.C. PAD FOR BUSSES AND DRILL PAD AREA
- STUDENTS TRANSPORTED BY BUS SYSTEM, SAFARI AND PARENTS.
- NO ISSUES W/ RETAINING WALLS
- PERIMETER FENCE IS IN BAD SHAPE.
- PLAY FIELD UNDER CONSTRUCTION
- ADEQUATE SIDEWALK/RAMPS
- G.T. INSIDE OF KITCHEN
- 1/3 OF FIELD IS SCHOOLS, 2/3 OF FIELD IS PARKS AND REC.
- SCHOOL WILL HAVE CART BLANCHE USE OF FIELD TO WEST DURING THE DAY.

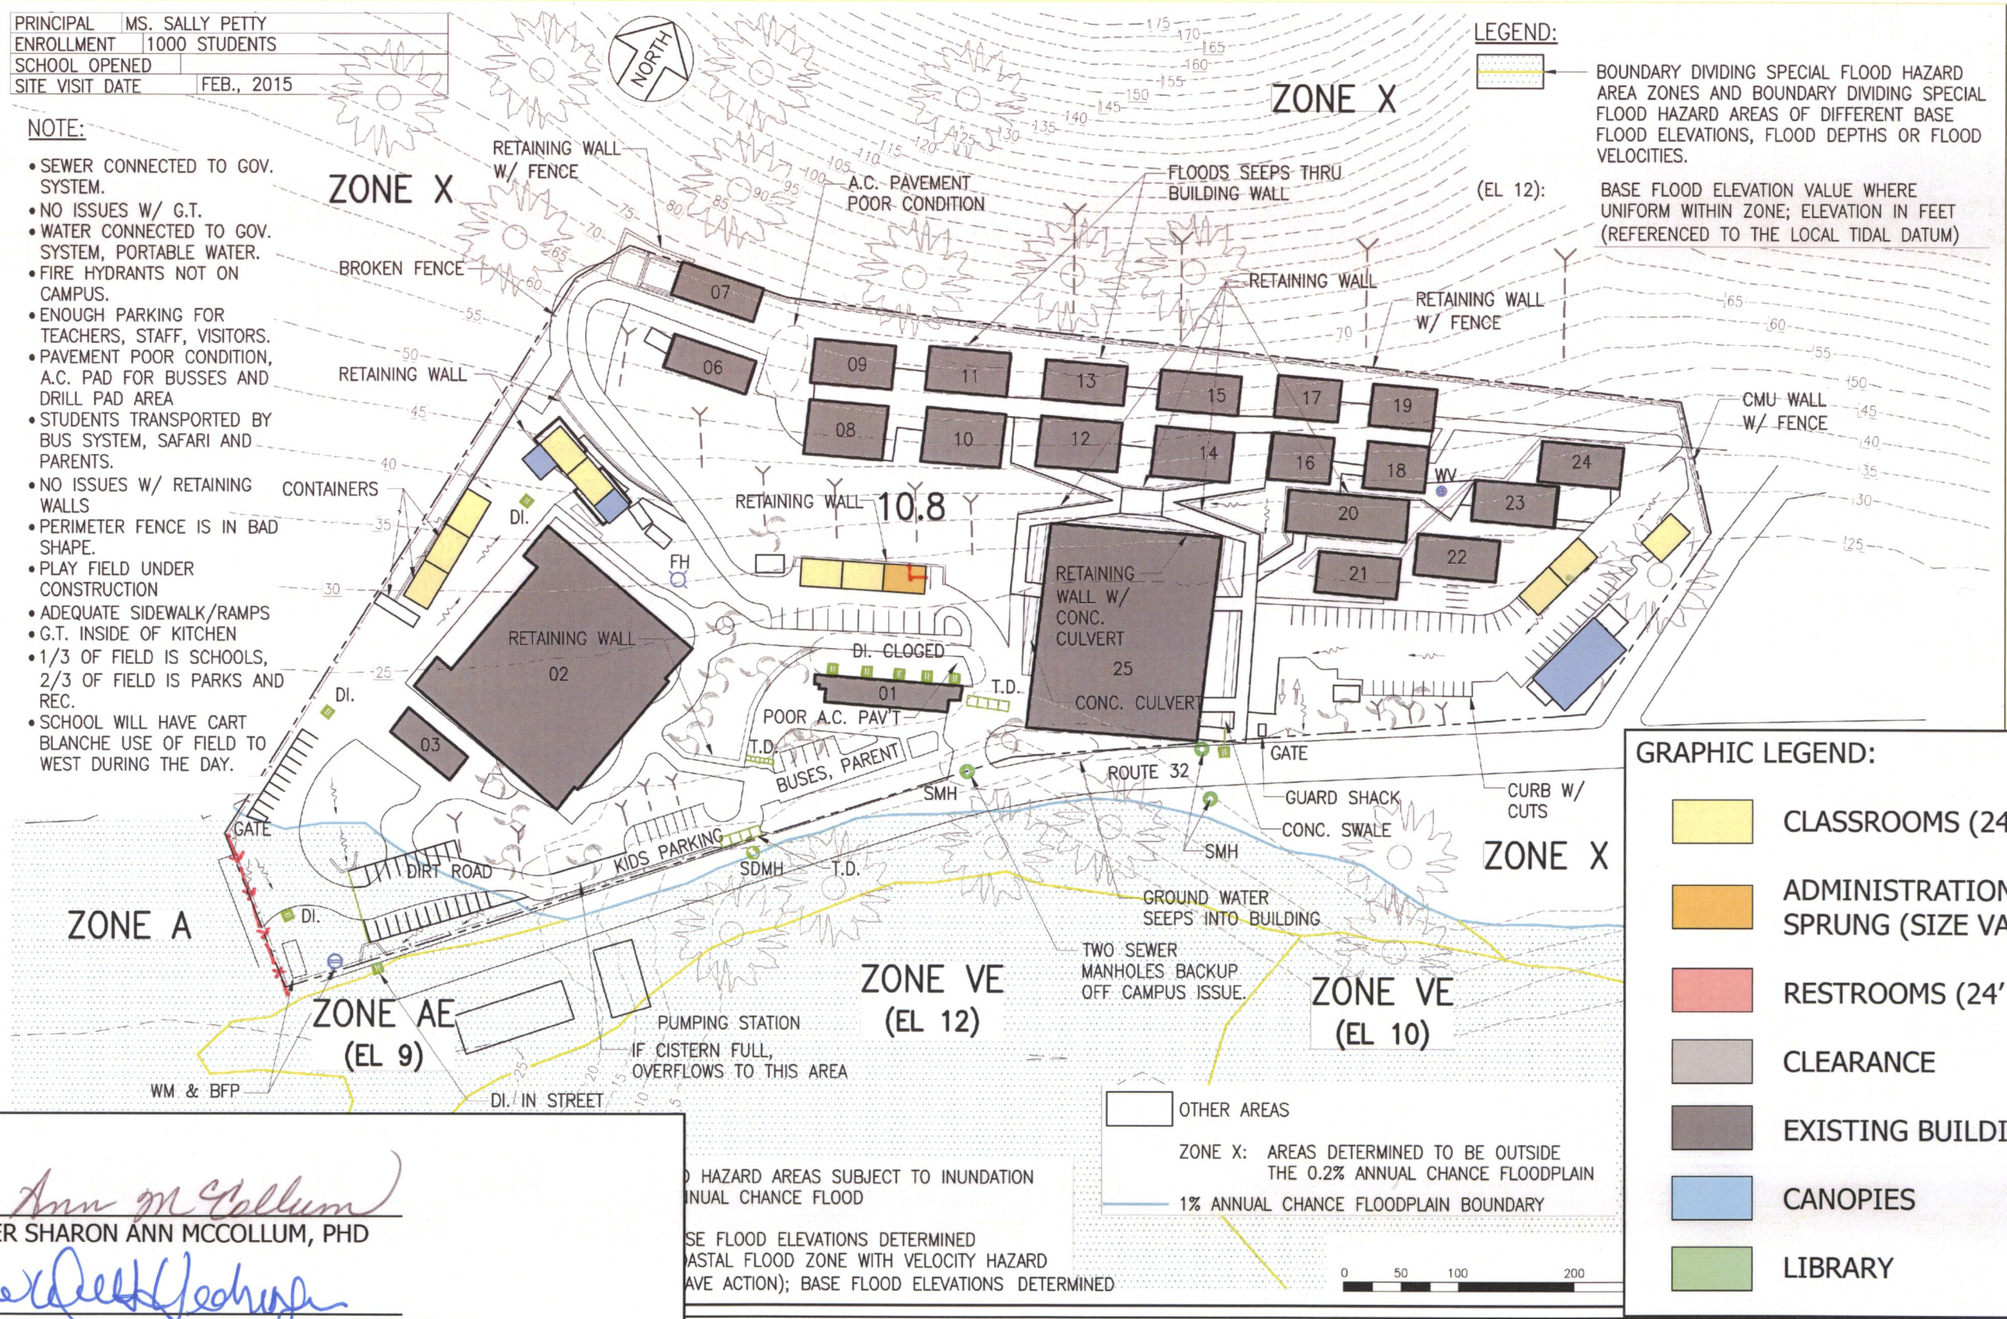

LEGEND:

BOUNDARY DIVIDING SPECIAL FLOOD HAZARD AREA ZONES AND BOUNDARY DIVIDING SPECIAL FLOOD HAZARD AREAS OF DIFFERENT BASE FLOOD ELEVATIONS, FLOOD DEPTHS OR FLOOD VELOCITIES.

(EL 12): BASE FLOOD ELEVATION VALUE WHERE UNIFORM WITHIN ZONE; ELEVATION IN FEET (REFERENCED TO THE LOCAL TIDAL DATUM)

GRAPHIC LEGEND:

- CLASSROOMS (24' X 36')
- ADMINISTRATION (24' X 36') SPRUNG (SIZE VARIES)
- RESTROOMS (24' X 33')
- CLEARANCE
- EXISTING BUILDINGS
- CANOPIES
- LIBRARY

APPROVALS:

COMMISSIONER SHARON ANN MCCOLLUM, PHD

INSULAR SUPERINTENDENT DIONNE WELLS - HEDRINGTON
ST.THOMAS - ST.JOHN DISTRICT

LOCATION: **IVANNA EUDORA KEAN HIGH SCHOOL** - ST. THOMAS , USVI
11 CLASSROOMS (24' X 36') , 1 ADMINISTRATION (24' X 36'), 3 CANOPIES
04 / 30 / 2018 REVISION 4

AECOM

SCALE: 1/128" = 1' - 0"

B/C OF

TO GET HERE.
PICK UP/
NO PROBLEMS.

ZONE A

DRAINAGE CHANNEL

CMU WALL W/ FENCE

HOLE

R

OVERGROWN

FENCE
GATE 05

AC
PAV'T

WALL

RETAINING WALL

RUNOFF PONDS
BEHIND WALL

CONC. SWALE
04

STAIRCASE

IN
WALL

RETAINING
WALL

ERT

OVERGROWN

RUN SERVICE FEEDER UNDERGROUND TO SERVICE PANEL

EXISTING UTILITY POLE. PROVIDE NEW POLE MOUNTED TRANSFORMER

SPACED GRASS

ACCESS ROAD

K (1) with service (janitorial storage)

A Admin

GRAPHIC LEGEND:

- CLASSROOMS (24' X 36')
- ADMINISTRATION (24' X 36') SPRUNG (SIZE VARIES)
- RESTROOMS (24' X 33')
- CLEARANCE
- EXISTING BUILDINGS
- SERVICE/STORAGE/KITCHEN
- LIBRARY

APPROVALS:

Sharon Ann McCollum

COMMISSIONER SHARON ANN MCCOLLUM, PHD

Dionne Wells-Hedrington

INSULAR SUPERINTENDENT DIONNE WELLS - HEDRINGTON
ST.THOMAS - ST.JOHN DISTRICT

LOCATION: **BENJAMIN OLIVER AT JOSEPH GOMEZ ELEMENTARY SCHOOL** - ST. THOMAS , USVI
8 CLASSROOMS (24' X 36') , 1 SERVICE
05 / 01 / 2018 REVISION 5

AECOM

SCALE: 1/64" = 1' - 0"

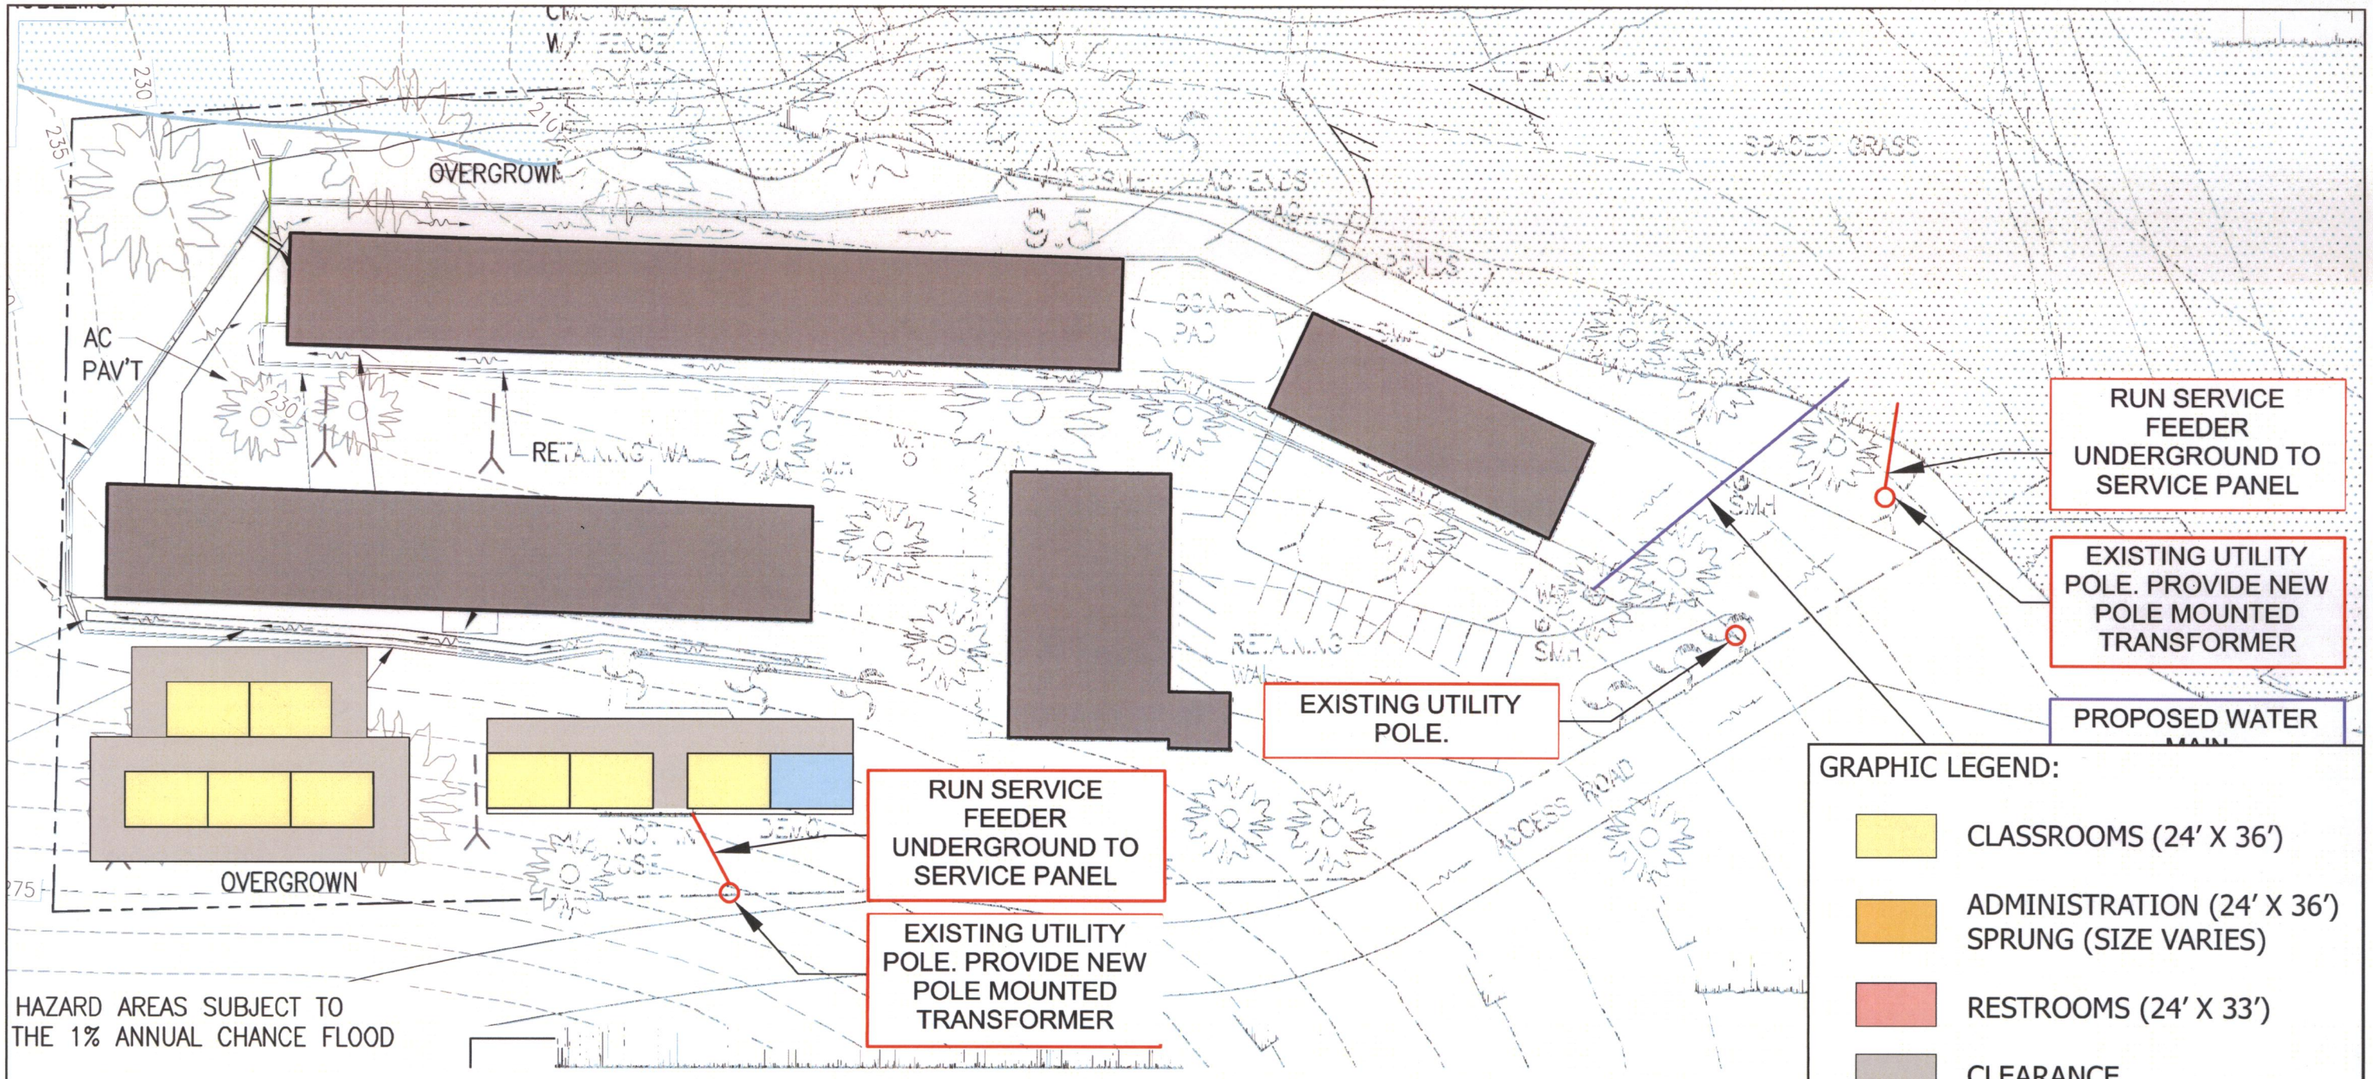

APPROVALS:

_____

COMMISSIONER SHARON ANN MCCOLLUM, PHD

_____

INSULAR SUPERINTENDENT DIONNE WELLS - HEDRINGTON
ST.THOMAS - ST.JOHN DISTRICT

LOCATION: **BENJAMIN OLIVER AT JOSEPH GOMEZ ELEMENTARY SCHOOL** - ST. THOMAS , USVI
8 CLASSROOMS (24' X 36') , 1 SERVICE
04 / 30 / 2018 REVISION 4

AECOM

SCALE: 1/64" = 1' - 0"

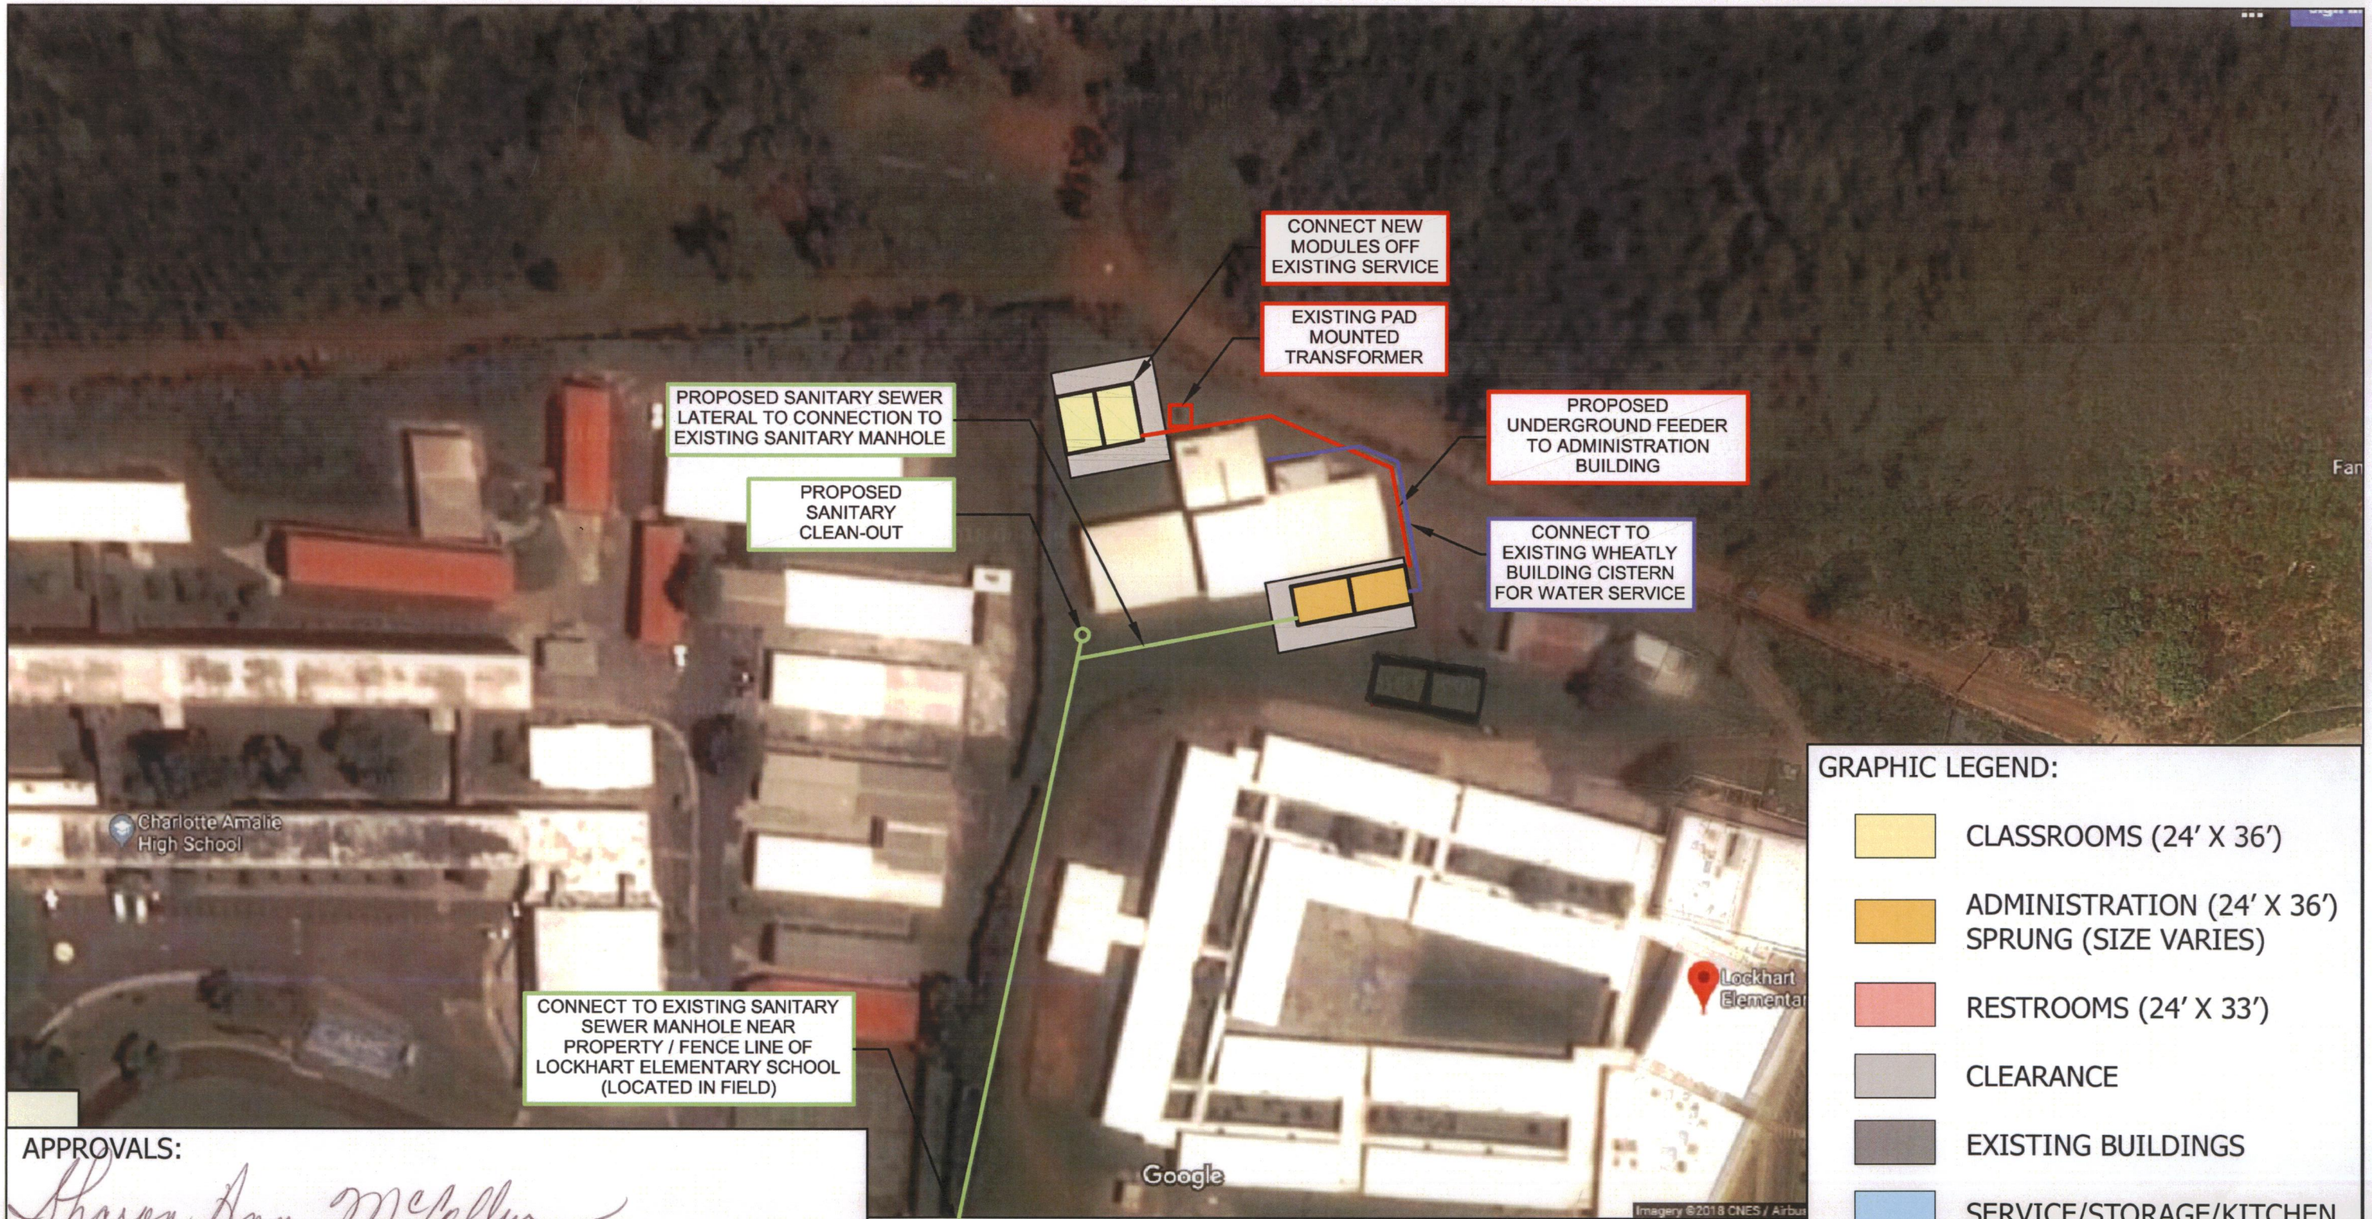

GRAPHIC LEGEND:

- CLASSROOMS (24' X 36')
- ADMINISTRATION (24' X 36') SPRUNG (SIZE VARIES)
- RESTROOMS (24' X 33')
- CLEARANCE
- EXISTING BUILDINGS
- SERVICE/STORAGE/KITCHEN
- LIBRARY

APPROVALS:

Sharon Ann McCollum

COMMISSIONER SHARON ANN MCCOLLUM, PHD

Dionne Wells-Hedrington

INSULAR SUPERINTENDENT DIONNE WELLS - HEDRINGTON
ST.THOMAS - ST.JOHN DISTRICT

LOCATION: **WHEATLEY SKILL CENTER** - ST. THOMAS , USVI
2 CLASSROOMS (24' X 36') , 2 ADMINISTRATION (24' X 36')
04 / 30 / 2018 REVISION 4

AECOM

SCALE: 1/128" = 1' - 0"

PRINCIPAL	MR. MOREHEAD
ENROLLMENT	428 STUDENTS
SCHOOL OPENED	1977
SITE VISIT DATE	FEB., 2015

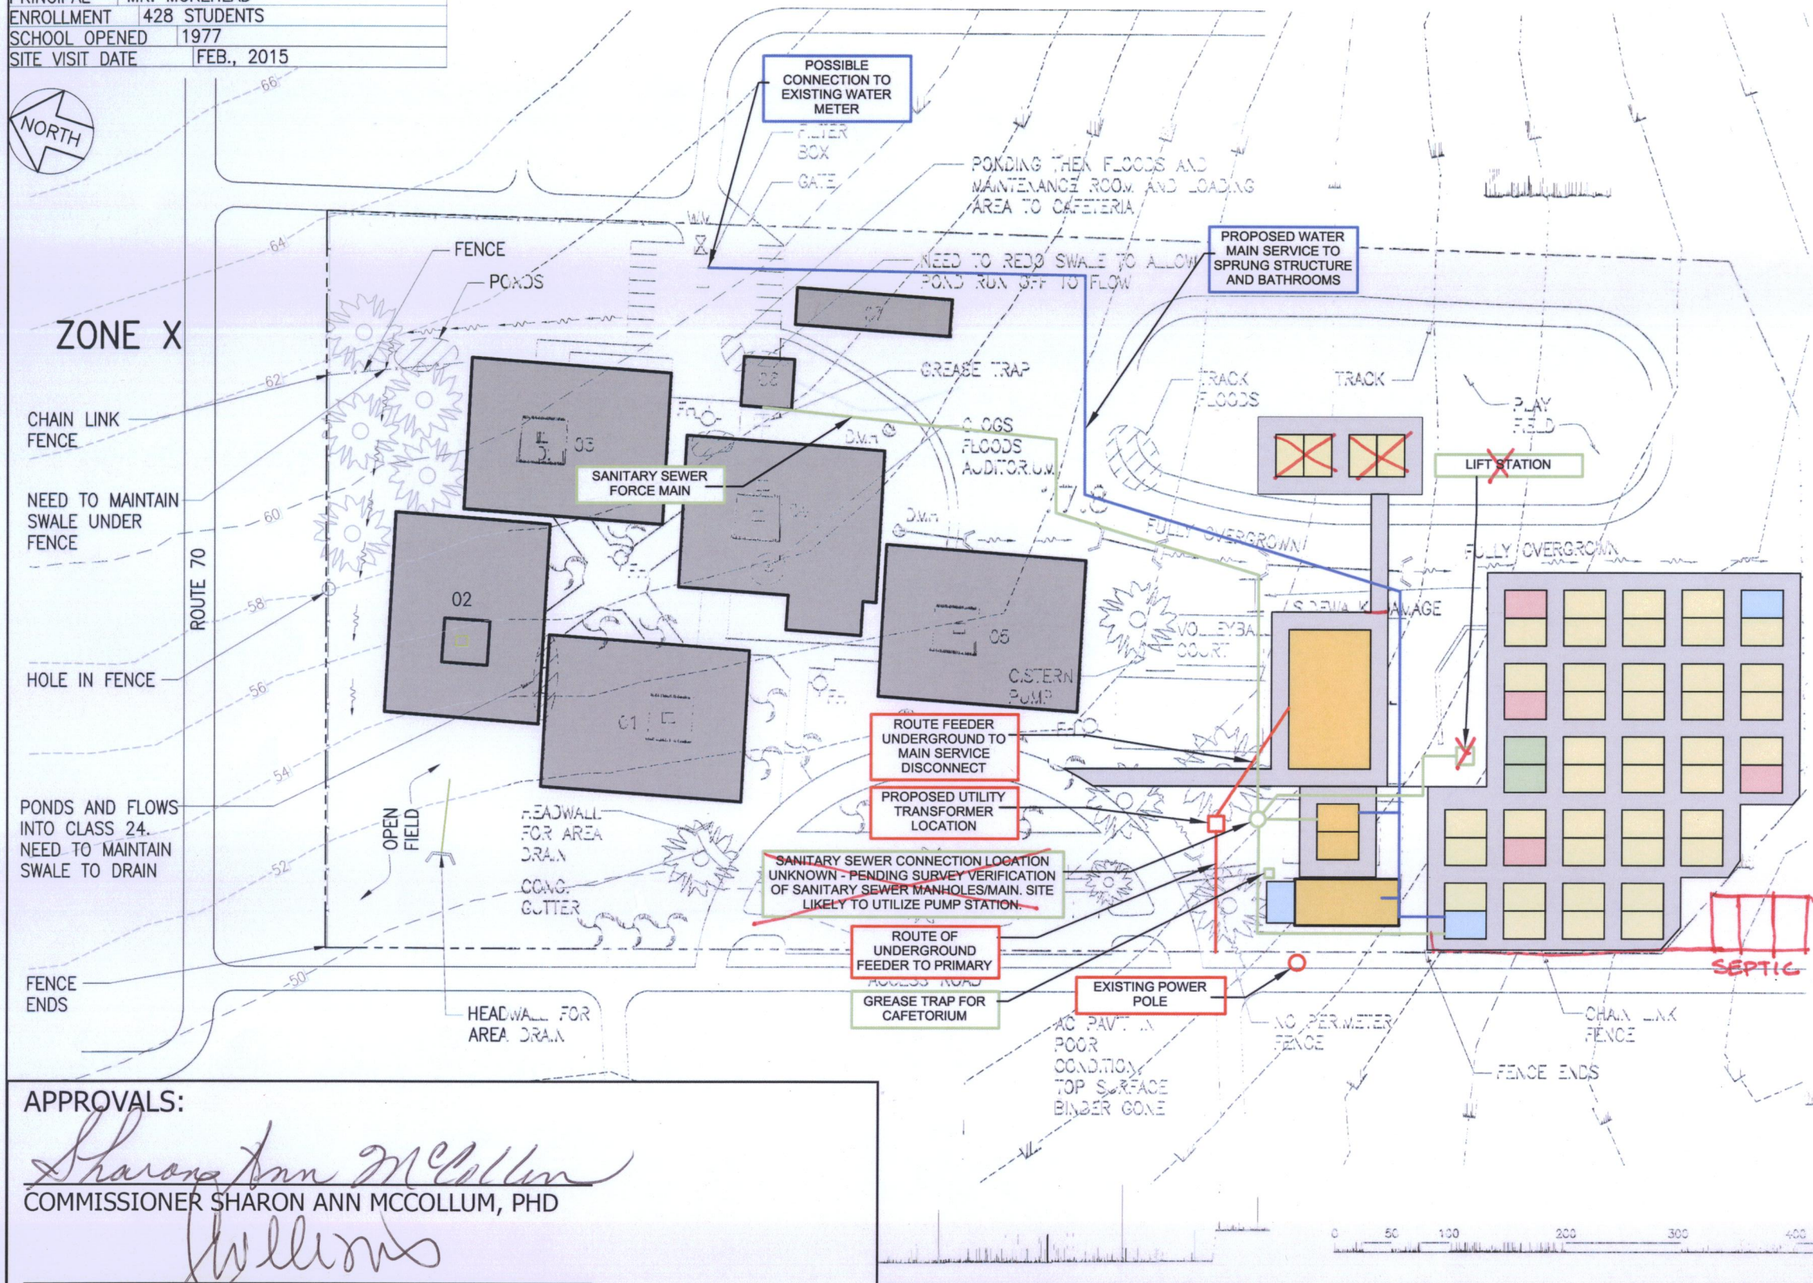

NOTE:

GRAPHIC LEGEND:

- CLASSROOMS (24' X 36')
- ADMINISTRATION (24' X 36') SPRUNG (SIZE VARIES)
- RESTROOMS (24' X 33')
- CLEARANCE
- EXISTING BUILDINGS
- SERVICE/STORAGE/KITCHEN
- LIBRARY

APPROVALS:

Sharon Ann McCollum

COMMISSIONER SHARON ANN MCCOLLUM, PHD

Williams

INSULAR SUPERINTENDENT COLLEEN MAE WILLIAMS
ST.CROIX SCHOOL DISTRICT

LOCATION: **ARTHUR A RICHARDS JUNIOR HIGH SCHOOL** - ST. CROIX , USVI

~~39~~ 46 CLASSROOMS (24'X36'), 2 ADMIN (24'X36'), 4 BATHROOM (24'X33'), 2 SPRUNG (70'x120') (40'x90'), 2 SERVICE (24'x36'), 2 LIBRARY (24'x36'), 1 KITCHEN (24'X36')

05 / 01 / 2018 REVISION 5

AECOM

SCALE: 1/128" = 1' - 0"

PRINCIPAL	MR. MOREHEAD
ENROLLMENT	428 STUDENTS
SCHOOL OPENED	1977
SITE VISIT DATE	FEB., 2015

NOTE:

NORTH

ZONE X

CHAIN LINK FENCE

NEED TO MAINTAIN SWALE UNDER FENCE

HOLE IN FENCE

PONDS AND FLOWS INTO CLASS 24. NEED TO MAINTAIN SWALE TO DRAIN

FENCE ENDS

ROUTE 70

POSSIBLE CONNECTION TO EXISTING WATER METER

FILTER BOX

GATE

POOLING THEN FLOODS AND MAINTENANCE ROOM AND LOADING AREA TO CAFETERIA

FENCE

PONDS

NEED TO REDO SWALE TO ALLOW POND RUN OFF TO FLOW

PROPOSED WATER MAIN SERVICE TO SPRUNG STRUCTURE AND BATHROOMS

GREASE TRAP

TRACK FLOODS

TRACK

PLAY FIELD

SANITARY SEWER FORCE MAIN

CLOGS FLOODS AUDITORIUM

LIFT STATION

FULLY OVERGROWN

VOLLEYBALL COURT

CISTERN PUMP

ROUTE FEEDER UNDERGROUND TO MAIN SERVICE DISCONNECT

PROPOSED UTILITY TRANSFORMER LOCATION

SANITARY SEWER CONNECTION LOCATION UNKNOWN - PENDING SURVEY VERIFICATION OF SANITARY SEWER MANHOLES/MAIN. SITE LIKELY TO UTILIZE PUMP STATION.

ROUTE OF UNDERGROUND FEEDER TO PRIMARY

GREASE TRAP FOR CAFETORIUM

EXISTING POWER POLE

AC PAVEMENT IN POOR CONDITION, TOP SURFACE BINDER GONE

NO PERIMETER FENCE

CHAIN LINK FENCE

FENCE ENDS

OPEN FIELD

HEADWALL FOR AREA DRAIN

CONC. GUTTER

HEADWALL FOR AREA DRAIN

0 50 100 200 300 400

GRAPHIC LEGEND:

- CLASSROOMS (24' X 36')
- ADMINISTRATION (24' X 36') SPRUNG (SIZE VARIES)
- RESTROOMS (24' X 33')
- CLEARANCE
- EXISTING BUILDINGS
- SERVICE/STORAGE/KITCHEN
- LIBRARY

APPROVALS:

_____

COMMISSIONER SHARON ANN MCCOLLUM, PHD

_____

INSULAR SUPERINTENDENT COLLEEN MAE WILLIAMS
ST.CROIX SCHOOL DISTRICT

LOCATION: **ARTHUR A RICHARDS JUNIOR HIGH SCHOOL** - ST. CROIX , USVI
46 CLASSROOMS (24'X36'), 2 ADMIN (24'X36'), 4 BATHROOM (24'X33'), 2 SPRUNG (90'x105') (30'x60'), 2 SERVICE (24'x36'), 2 LIBRARY (24'x36'), 1 KITCHEN (24'X36')
04 / 30 / 2018 REVISION 4

AECOM

SCALE: 1/128" = 1' - 0"

PRINCIPAL	MR. MOREHEAD
ENROLLMENT	
SCHOOL OPENED	1982
SITE VISIT DATE	FEB., 2015

NOTE:

- SOME CLASSROOMS FLOOD WHEN IT RAINS HEAVILY.
- SCHOOL BUILT IN FLOOD WAY.
- POTABLE WATER CONNECTED TO GOV. SYSTEM, NO ISSUES.
- SEWER CONNECTED TO GOVERNMENT SYSTEM. GREASE INTERCEPTOR REQUIRES REGULAR MAINTENANCE.
- FH's LOCATED ONSITE.
- PARKING LOT REDONE 4-5 YEARS AGO. ADEQUATE PARKING.
- MUST CLEAR DRAINAGE WAY
- MOST STUDENTS BUSSED 65%.
- NOT MAJOR ISSUE W/ PICK UP/ DROP OFF BUT COULD BE BETTER.
- NO RETAINING WALLS.
- FENCE HAS MINOR HOLES.
- PLAYING FIELD IS POOR CONDITION HOLES.
- S/W GOOD CONDITION, RAMPS ARE VERY GOOD.

LEGEND:

SMH: SEWER MANHOLE
DI: DRAIN INLET
FH: FIRE HYDRANT
WM: WATER METER
HW: HEAD WALL

ZONE X: AREAS DETERMINED TO BE OUTSIDE THE 0.2% ANNUAL CHANCE FLOODPLAIN

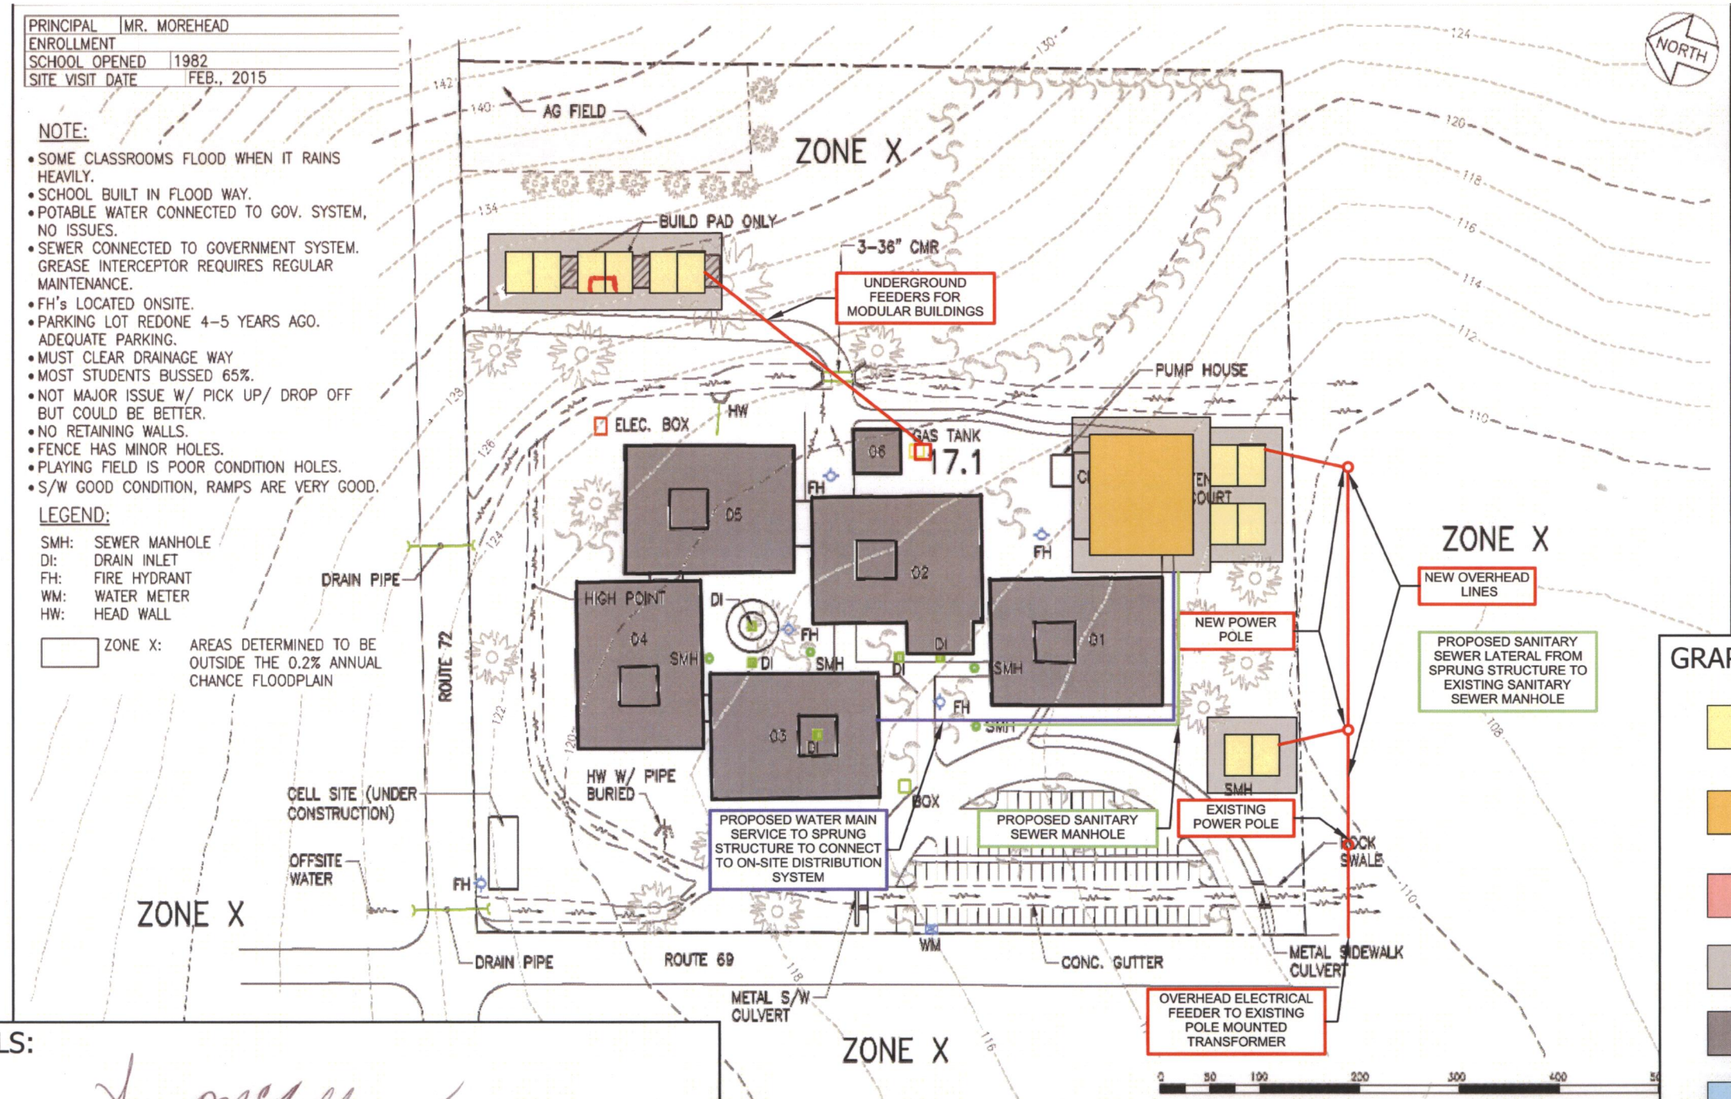

GRAPHIC LEGEND:

- CLASSROOMS (24' X 36')
- ADMINISTRATION (24' X 36') SPRUNG (SIZE VARIES)
- RESTROOMS (24' X 33')
- CLEARANCE
- EXISTING BUILDINGS
- SERVICE/STORAGE/KITCHEN
- LIBRARY

APPROVALS:

Sharon Ann McCollum

COMMISSIONER SHARON ANN MCCOLLUM, PHD

INSULAR SUPERINTENDENT COLLEEN MAE WILLIAMS
ST.CROIX SCHOOL DISTRICT

LOCATION: **JOHN H. WOODSON JUNIOR HIGH SCHOOL** - ST. CROIX, USVI
12 CLASSROOMS (24' X 36'), 1 SPRUNG (90' X 105')
04 / 30 / 2018 REVISION 4

AECOM

SCALE: 1/128" = 1' - 0"

PRINCIPAL	MS. BROW, MS. MOREHEAD
ENROLLMENT	363 STUDENTS
SCHOOL OPENED	1965
SITE VISIT DATE	FEB., 2015

NORTH

ZONE A

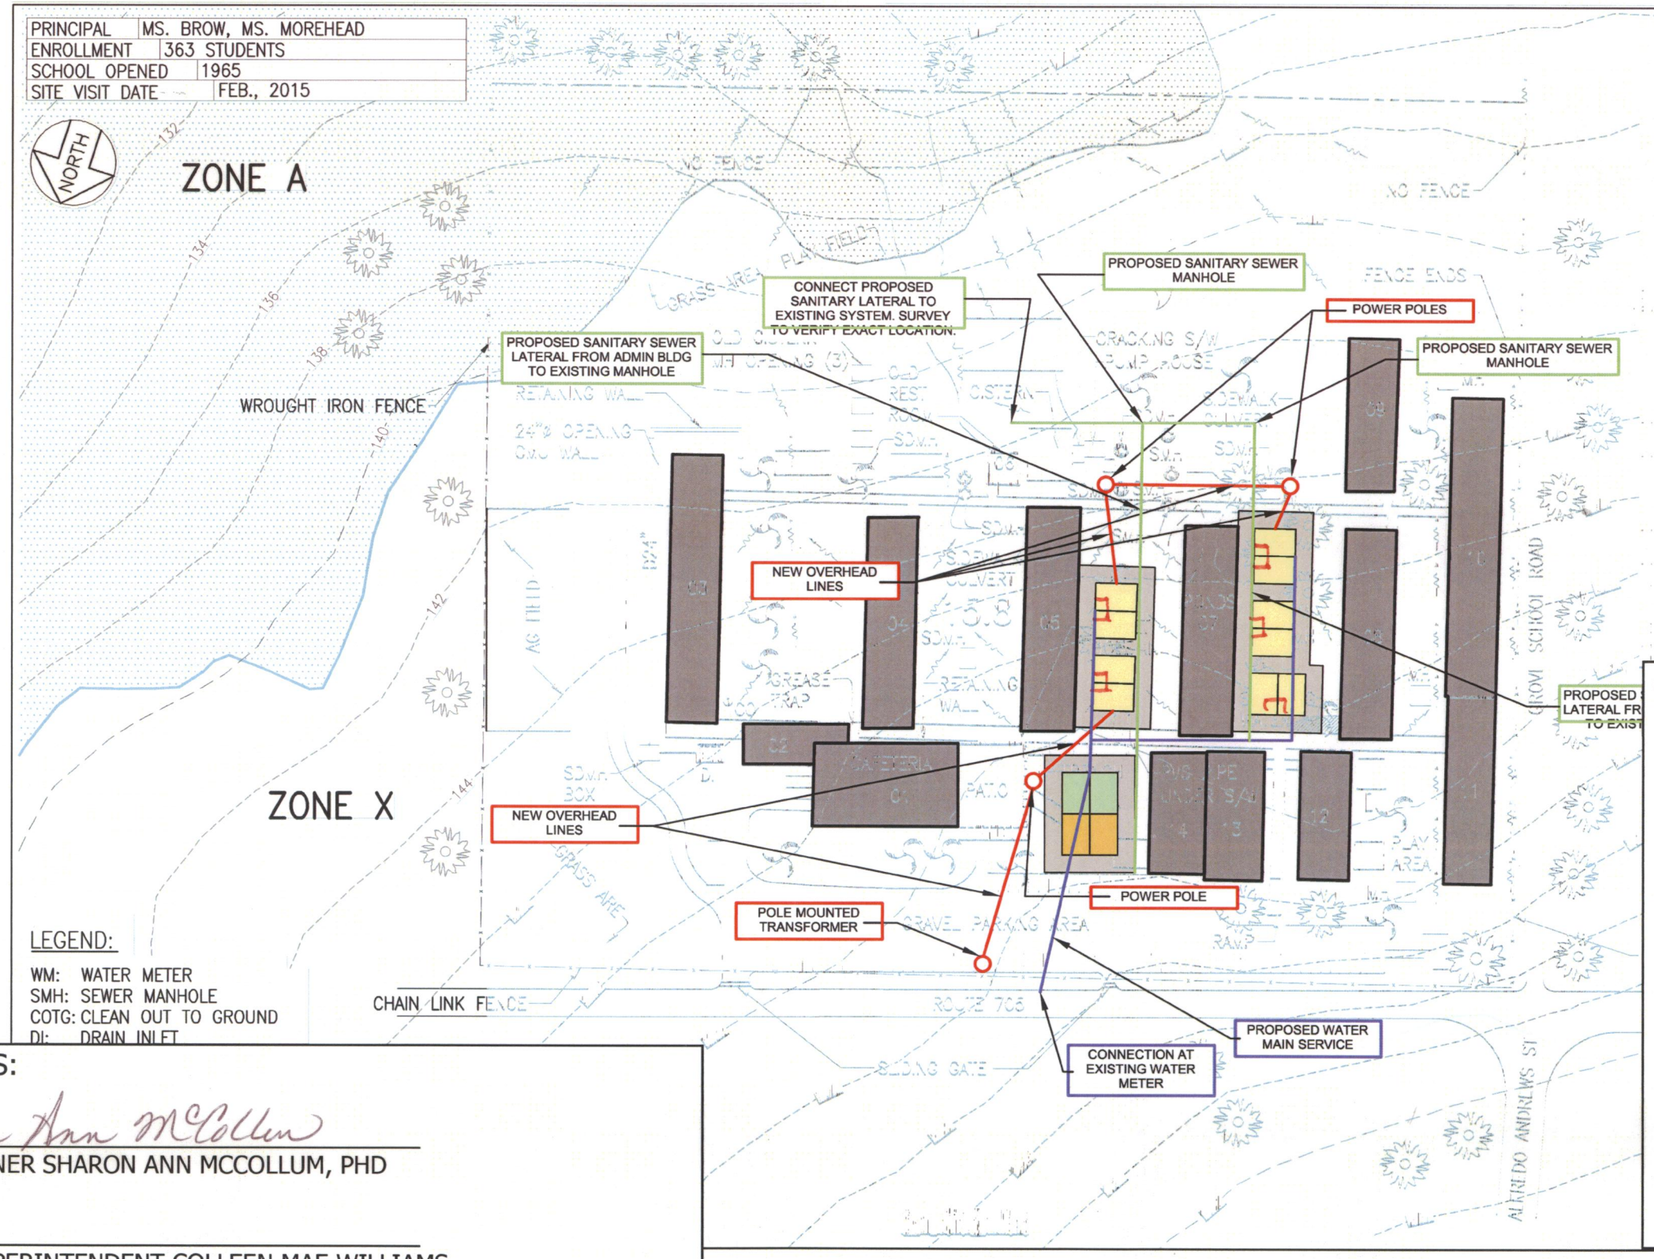

LEGEND:

WM: WATER METER
SMH: SEWER MANHOLE
COTG: CLEAN OUT TO GROUND
DI: DRAIN INLET

GRAPHIC LEGEND:

- CLASSROOMS (24' X 36')
- ADMINISTRATION (24' X 36') SPRUNG (SIZE VARIES)
- RESTROOMS (24' X 33')
- CLEARANCE
- EXISTING BUILDINGS
- SERVICE/STORAGE/KITCHEN
- LIBRARY

APPROVALS:

Sharon Ann McCollum

COMMISSIONER SHARON ANN MCCOLLUM, PHD

INSULAR SUPERINTENDENT COLLEEN MAE WILLIAMS
ST.CROIX SCHOOL DISTRICT

LOCATION: **EULALIE RIVERA ELEMENTARY SCHOOL** - ST. CROIX , USVI
10 CLASSROOMS (24' X 36'), 4 ADMINISTRATION (24' X 36'), 2 LIBRARY
04 / 30 / 2018 REVISION 4

AECOM

SCALE: 1/128" = 1' - 0"

PROPOSED SANITARY SEWER LATERAL FROM ADMIN BUILDING TO EXISTING SANITARY SEWER MANHOLE

OVERHEAD POWER LINES

POWER POLE

PROPOSED WATER MAIN SERVICE TO ADMIN BUILDING

POWER POLE WITH EXISTING SERVICE

POSSIBLE CONNECTION AT EXISTING WATER METER

ITCHED TO GOVERNMENT
DOR FROM
CE.
N CAMPUS
GH PARKING FOR STAFF
ORS, AND DELIVERIES.
WITH GREA
ORS.
DROPPED OFF OR
E STREETS ONE WAY
CK UP AND DROP OFF
OKAY.
AVE FENCE

ES IN FENC
ATES (MOTORIZED) AND
ROUND AC UNITS.
ED TO BE RESURFACED/
SHED
COMPLIANT
RDEN NEEDS TO
FENCE.
SLIPPERY WHEN WET.
ELD DOES NOT DRAIN
E HOLES IN FIELD THAT
FILLED

APPROVALS:

Sharon Ann McCollum

COMMISSIONER SHARON ANN MCCOLLUM, PHD

INSULAR SUPERINTENDENT COLLEEN MAE WILLIAMS
ST.CROIX SCHOOL DISTRICT

GRAPHIC LEGEND:

- CLASSROOMS (24' X 36')
- ADMINISTRATION (24' X 36') SPRUNG (SIZE VARIES)
- RESTROOMS (24' X 33')
- CLEARANCE
- EXISTING BUILDINGS
- SERVICE/STORAGE/KITCHEN
- LIBRARY

LOCATION: **LEW MUCKLE ELEMENTARY SCHOOL** - ST. CROIX , USVI
2 CLASSROOMS (24' X 36'), 2 ADMINISTRATION (24' X 36'), 2 LIBRARY (24' x 36')
04 / 30 / 2018 REVISION 4

AECOM

SCALE: 1/64" = 1' - 0"

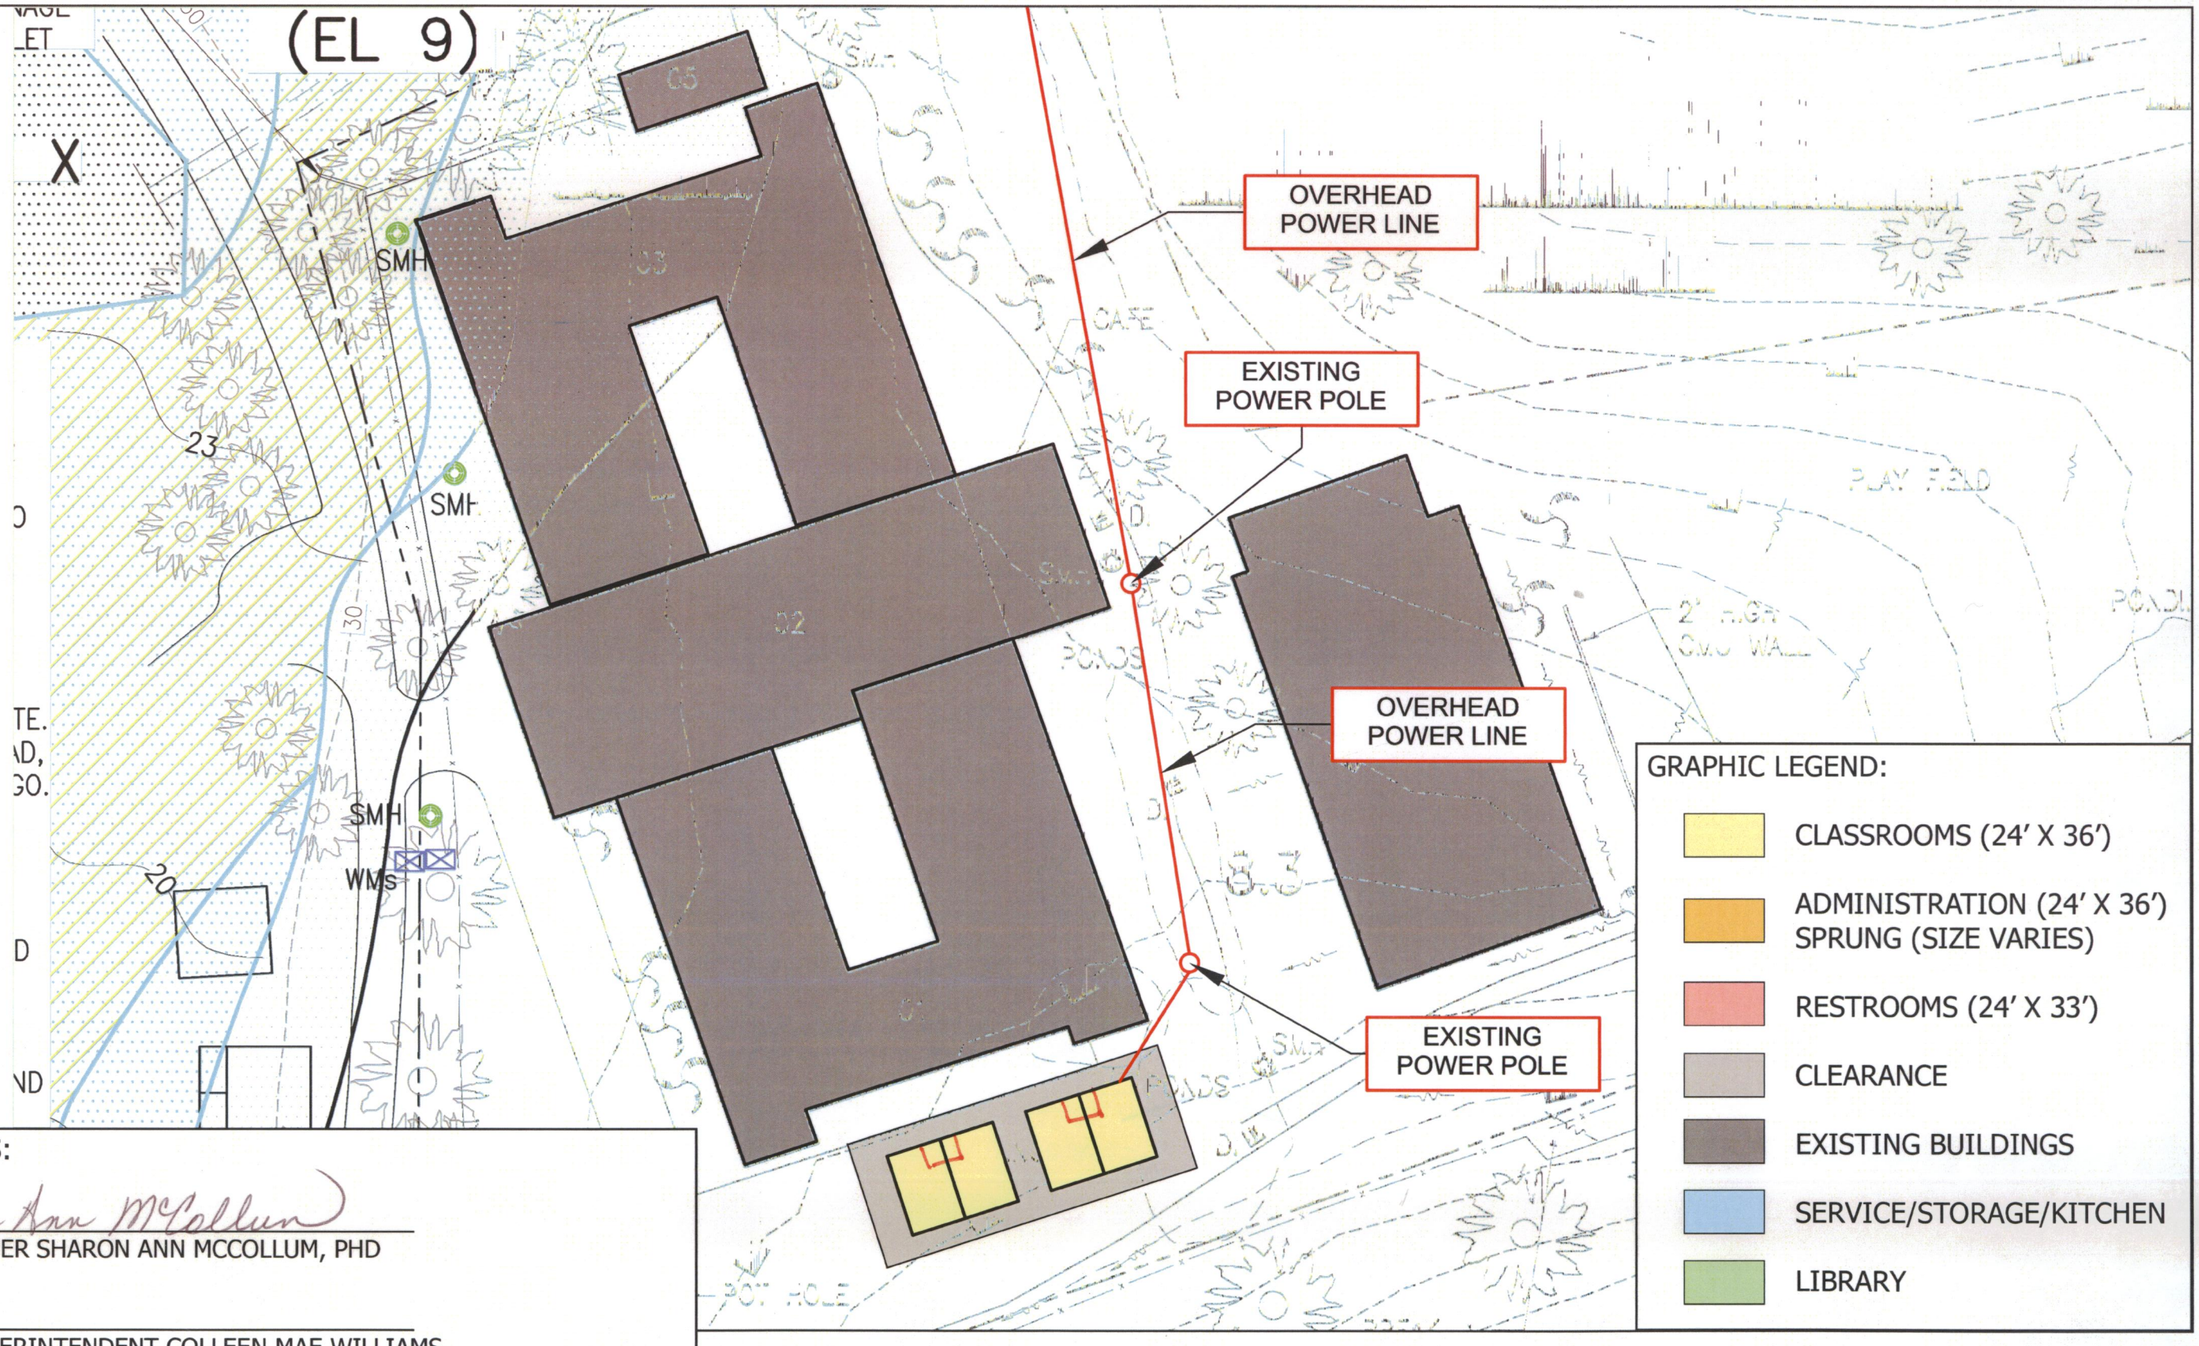

APPROVALS:

Sharon Ann McCollum

COMMISSIONER SHARON ANN MCCOLLUM, PHD

INSULAR SUPERINTENDENT COLLEEN MAE WILLIAMS
ST.CROIX SCHOOL DISTRICT

LOCATION: **PEARL B. LARSEN ELEMENTARY SCHOOL** - ST. CROIX , USVI
4 CLASSROOMS (24' X 36')
04 / 30 / 2018 REVISION 4

AECOM

SCALE: 1/64" = 1' - 0"

SIBLE FIRE HYDRANT ALONG STREET, POSSIBLE
HYDRANT RISERS ON CAMPUS, UNCLEAR IF THEY
OPERATIONAL.
PAV'T GOOD CONDITION, ADEQUATE PARKING FOR
ENTS (ONLY SENIORS CAN PARK), STAFF AND
ORS.
STUDENTS BUSED, CONGESTED MOVEMENT.
RETAINING WALLS.
E HOLES IN OUTER FENCE.
ING FIELD RECENTLY REGRADED, DRAINS WELL,
RE PROJECT TO ADD A TRACK AND FIELD.
WALKWAYS BETWEEN BUILDINGS, SOME CRACKING.

ID:

ATER METER
EWER MANHOLE
RAIN INLET
RE HYDRANT
YMNASTIC
LEAN OUT TO GROUND
ZONE X: AREAS DETERMINED TO BE OU
0.2% ANNUAL CHANCE FLOOD

ZONE X

IRON FENCE

PONDING

GATE

COVERED AREA

GRASS FIELD

23.7

CISTERN

GUARD HOUSE

GATE

PAVED AREA

GATE

GATE

FUSER STATION

EMERGENCY GENERATOR

FUEL TANK

ACCESS ROAD

GATE

SMH

DI

WM

GRAPHIC LEGEND:

- CLASSROOMS (24' X 36')
- ADMINISTRATION (24' X 36') SPRUNG (SIZE VARIES)
- RESTROOMS (24' X 33')
- CLEARANCE
- EXISTING BUILDINGS
- LOCKERS AND SHOWERS
- LIBRARY

APPROVALS:

Sharon Ann McCollum

COMMISSIONER SHARON ANN MCCOLLUM, PHD

INSULAR SUPERINTENDENT COLLEEN MAE WILLIAMS
ST.CROIX SCHOOL DISTRICT

LOCATION: **CENTRAL HIGH SCHOOL** - ST. CROIX , USVI
1 SPRUNG (90' X 120'), 3 CLASSROOMS (24' X 36'), 1 BATHROOM (24' X 33'), 3 SERVICE
04 / 30 / 2018 REVISION 4

AECOM

SCALE: 1/128" = 1' - 0"